


END TEMPORARY WEIGH STATION GRADING PLAN
STA. 13+540.0 RT

FILE NAME = \\s116\vaot\CONTRACT3\VTGP5.dgn
DATE/TIME = 10/11/2001
USER = 664

DATUM	
VERTICAL	NAVD 88
HORIZONTAL	NAD 83 (1992)

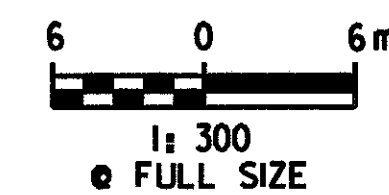

TEMPORARY WEIGH STATION GRADING PLAN	SURVEYED BY	C.H.A. & V.S.E.	DATE	12/93
	DESIGNED BY	D.E.G.	DATE	11/01
	DRAWN BY	C.A.K.	DATE	11/01
	CHECKED BY	T.P.K.	DATE	11/01
	DESIGN FILE NO.	/5116/vaot/c/3/vtgp1.dgn		
PROJ. NAME	BENNINGTON - HOOSICK D.P.L. 01460) C/3			
PROJ. NO.	P.L.N. 1306.60			
DWG NO.	GP-5	SHEET 106 OF 473		