

SPARKS, WILLIAM
 END BENNINGTON - HOOSICK D.P.I. 0146(I) C/2
 BEGIN BENNINGTON - HOOSICK D.P.I. 0146(I) C/3
 BEGIN ROADWAY
 STA. 12+130.455

N.Y. ROUTE 7 CONSTRUCTED BY
 OTHERS UNDER BENNINGTON -
 HOOSICK D.P.I. 0146(I) C/2 CONTRACT

END EASTBOUND CLIMBING LANE TAPER
 END EASTBOUND SHOULDER WIDENING
 END WESTBOUND CLIMBING LANE WIDENING
 BEGIN FULL-WIDTH WESTBOUND CLIMBING LANE
 BEGIN WESTBOUND SHOULDER WIDENING
 END WESTBOUND SHOULDER TAPER
 STA. 12+230.000

NEW 150 mm X 40 m UNDERDRAIN PIPE
 W/ 150 mm X 10 m CARRIER PIPE
 STA. 12+370.0 - STA. 12+420.0 RT

NEW UNDERDRAIN FLUSHING BASIN
 STA. 12+380.0-RT
 12+379.0 RMT 1/31/06

MATCH LINE STA. 12+420.000 DWG. DP-2

PROPOSED MAINTENANCE
 VEHICLE TURN-AROUND
 SEE DWG. NO. MD-1

SPECIAL DITCH W/TYPE II
 STONE-FILL
 STA. 12+116.0 - STA. 12+420.0 RT

BEGIN EASTBOUND SHOULDER WIDENING
 STA. 12+210.000


STATE OF VERMONT
 (FORMERLY WOODLAND HEIGHTS
 REALTY CO)

AS-BUILT NOTE: SEE UNDERDRAIN FLUSHING BASIN CHANGE ON THIS SHEET.
 RMT 2/1/06

FILE NAME = u:\5116\VAOT\CONTRACTS\VTDP8.DGN
 DATE/TIME = 10/11/2001
 USER = 684

DATUM

VERTICAL	NAVD 88
HORIZONTAL	NAD 83 (992)

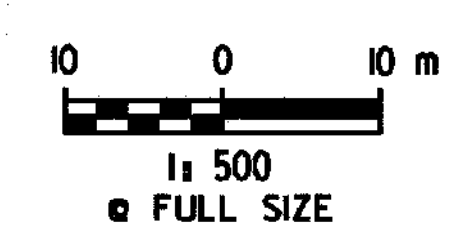

DRAINAGE PLAN

SURVEYED BY	C.H.A. & V.S.E.	DATE	12/93
DESIGNED BY	D.E.G.	DATE	11/01
DRAWN BY	J.S.L.	DATE	11/01
CHECKED BY	T.P.K.	DATE	11/01
DESIGN FILE NO.	/5116/vaot/vt dp8.dgn		
PROJ. NAME	BENNINGTON - HOOSICK D.P.I. 0146(I) C/3		
PROJ. NO.	P.I.N. 1306.60		
DWG. NO. DP-1	SHEET 108 OF 473		