


- NOTES:
- DIMENSIONS FOR STONE PADS ARE GIVEN IN THE FOLLOWING FORMAT: (WIDTH x LENGTH).
  - DRAINAGE PIPE OPTIONS ARE AS FOLLOWS:
    - OPTION A - RCP
    - OPTION B - PCCSP
    - OPTION C - CAAP
    - OPTION D - CPEP(SL)
    - OPTION E - PCCSP(W/PI)
    - OPTION F - CPEP

AS-BUILT NOTE: SEE UNDER DRAIN PIPE CROSSING ADDED ON THIS SHEET

<b>DRAINAGE PLAN</b>		SURVEYED BY C.H.A. & V.S.E.	DATE 12/93
		DESIGNED BY D.E.G.	DATE 11/01
		DRAWN BY J.S.L.	DATE 11/01
		CHECKED BY T.P.K.	DATE 11/01
DESIGN FILE NO. /5116/vaot/vtdpl0.dgn		PROJ. NAME BENNINGTON - HOOSICK D.P.I. 0146(1) C/3	
PROJ. NO. P.I.N. 1306.60		DWG NO. DP-3	
		SHEET 110 OF 473	

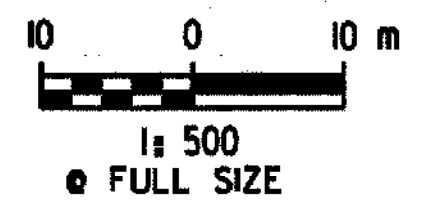

FILE NAME = \\5116\VAOT\CONTRACTS\VAOT\DP10.DGN  
 DATE/TIME = 10/15/2001  
 USER = 664

<b>DATUM</b>	
VERTICAL	NAVD 88
HORIZONTAL	NAD 83 (1992)