


MATCH LINE STA. 13+480.000 DWG. DP-4

MATCH LINE STA. 13+800.000 DWG. DP-6

FILE NAME = \\s116\vaot\contract3\vt\dp12.dgn
DATE/TIME = 10/24/01
USER = 1459

DATUM	
VERTICAL	NAVD 88
HORIZONTAL	NAD 83 (992)

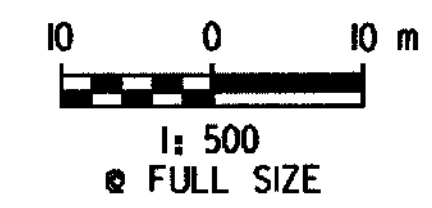

AS-BUILT NOTES: SEE UNDERDRAIN FLUSHING BASINS ON THIS SHEET

DRAINAGE PLAN	SURVEYED BY	C.H.A. & V.S.E.	DATE	12/93
	DESIGNED BY	D.E.G.	DATE	11/01
	DRAWN BY	J.S.L.	DATE	11/01
	CHECKED BY	T.P.K.	DATE	11/01
DESIGN FILE NO. /5116/vaot/vt\dp12.dgn				
PROJ. NAME BENNINGTON - HOOSICK D.P.L. 0146(1) C/3				
PROJ. NO. P.I.N. 1306.60				
DWG NO. DP-5 SHEET 112 OF 473				