


MATCH LINE STA. 15+560.000 DWG. DP-10

MATCH LINE STA. 15+900.000 DWG. DP-12

FILE NAME = \\5116\VAOT\CONTRACT3\VTDP18.DGN  
DATE/TIME = 10/11/2001  
USER = 664

DATUM	
VERTICAL	NAVD 88
HORIZONTAL	NAD 83 (1992)

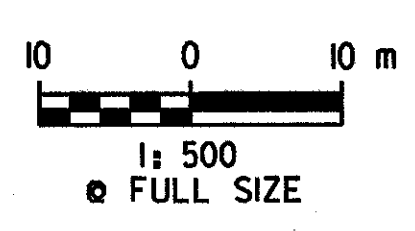

<b>DRAINAGE PLAN</b>	SURVEYED BY	C.H.A. & V.S.E.	DATE	12/93
	DESIGNED BY	D.E.G.	DATE	11/01
	DRAWN BY	J.S.L.	DATE	11/01
	CHECKED BY	T.P.K.	DATE	11/01
DESIGN FILE NO.	/5116/vaot/vtdp18.dgn			
PROJ. NAME	BENNINGTON - HOOSICK D.P.I. 014610 C/3			
PROJ. NO.	P.I.N. 1306.60			
DWG NO. DP-11				SHEET 118 OF 473