


MATCH LINE STA. 15+900.000 DWG. DP-11

MATCH LINE STA. 16+260.000 DWG. DP-13

FILE NAME = F:\5116\VAOT\CONTRACT3\VTDP19.DGN
DATE/TIME = 10/15/2001
USER = 664

DATUM	
VERTICAL	NAVD 88
HORIZONTAL	NAD 83 (992)

- NOTES:**
- DIMENSIONS FOR STONE PADS ARE GIVEN IN THE FOLLOWING FORMAT: (WIDTH x LENGTH).
 - DRAINAGE PIPE OPTIONS ARE AS FOLLOWS:
 - OPTION A - RCP
 - OPTION B - PCCSP
 - OPTION C - CAAP
 - OPTION D - CPEP(SL)
 - OPTION E - PCCSP(W/PI)
 - OPTION F - CPEP

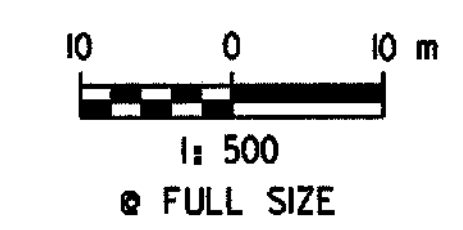

AS-BUILT NOTE: (4) ADDITIONAL STONE LINED SWALES A.O.B.E. DUE TO WASHOUTS. RMT 2/1/06

DRAINAGE PLAN

SURVEYED BY	C.H.A. & V.S.E.	DATE	12/93
DESIGNED BY	D.E.G.	DATE	11/01
DRAWN BY	J.S.L.	DATE	11/01
CHECKED BY	T.P.K.	DATE	11/01
DESIGN FILE NO.	/5116/vaot/vtDP19.dgn		
PROJ. NAME	BENNINGTON - HOOSICK D.P.I. 0146(1) C/3		
PROJ. NO.	P.L.N. 1306.60		
DWG NO.	DP-12	SHEET	119 OF 473