


MATCH LINE STA. 16+260.000 DWG. DP-12

MATCH LINE STA. 16+580.000

FILE NAME = J:\5116\VAOT\CONTRACTS\VTDP20.DGN
 DATE/TIME = 10/11/2001
 USER = 664

DATUM	
VERTICAL	NAVD 88
HORIZONTAL	NAD 83 (1992)

- NOTES:**
- DIMENSIONS FOR STONE PADS ARE GIVEN IN THE FOLLOWING FORMAT: (WIDTH x LENGTH).
 - DRAINAGE PIPE OPTIONS ARE AS FOLLOWS:
 - OPTION A - RCP
 - OPTION B - PCCSP
 - OPTION C - CAAP
 - OPTION D - CPEP(SL)
 - OPTION E - PCCSP(W/P)
 - OPTION F - CPEP

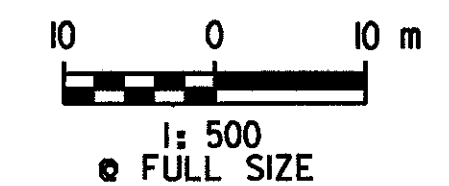

DRAINAGE PLAN	SURVEYED BY	C.H.A. & V.S.E.	DATE	12/93
	DESIGNED BY	D.E.G.	DATE	11/01
	DRAWN BY	J.S.L.	DATE	11/01
	CHECKED BY	T.P.K.	DATE	11/01
DESIGN FILE NO.	5116/vaot/vt20.dgn			
PROJ. NAME	BENNINGTON - HOOSICK D.P.I. 014610 C/3			
PROJ. NO.	P.I.N. 1306.60			
DWG NO.	DP-13	SHEET		120 OF 473