
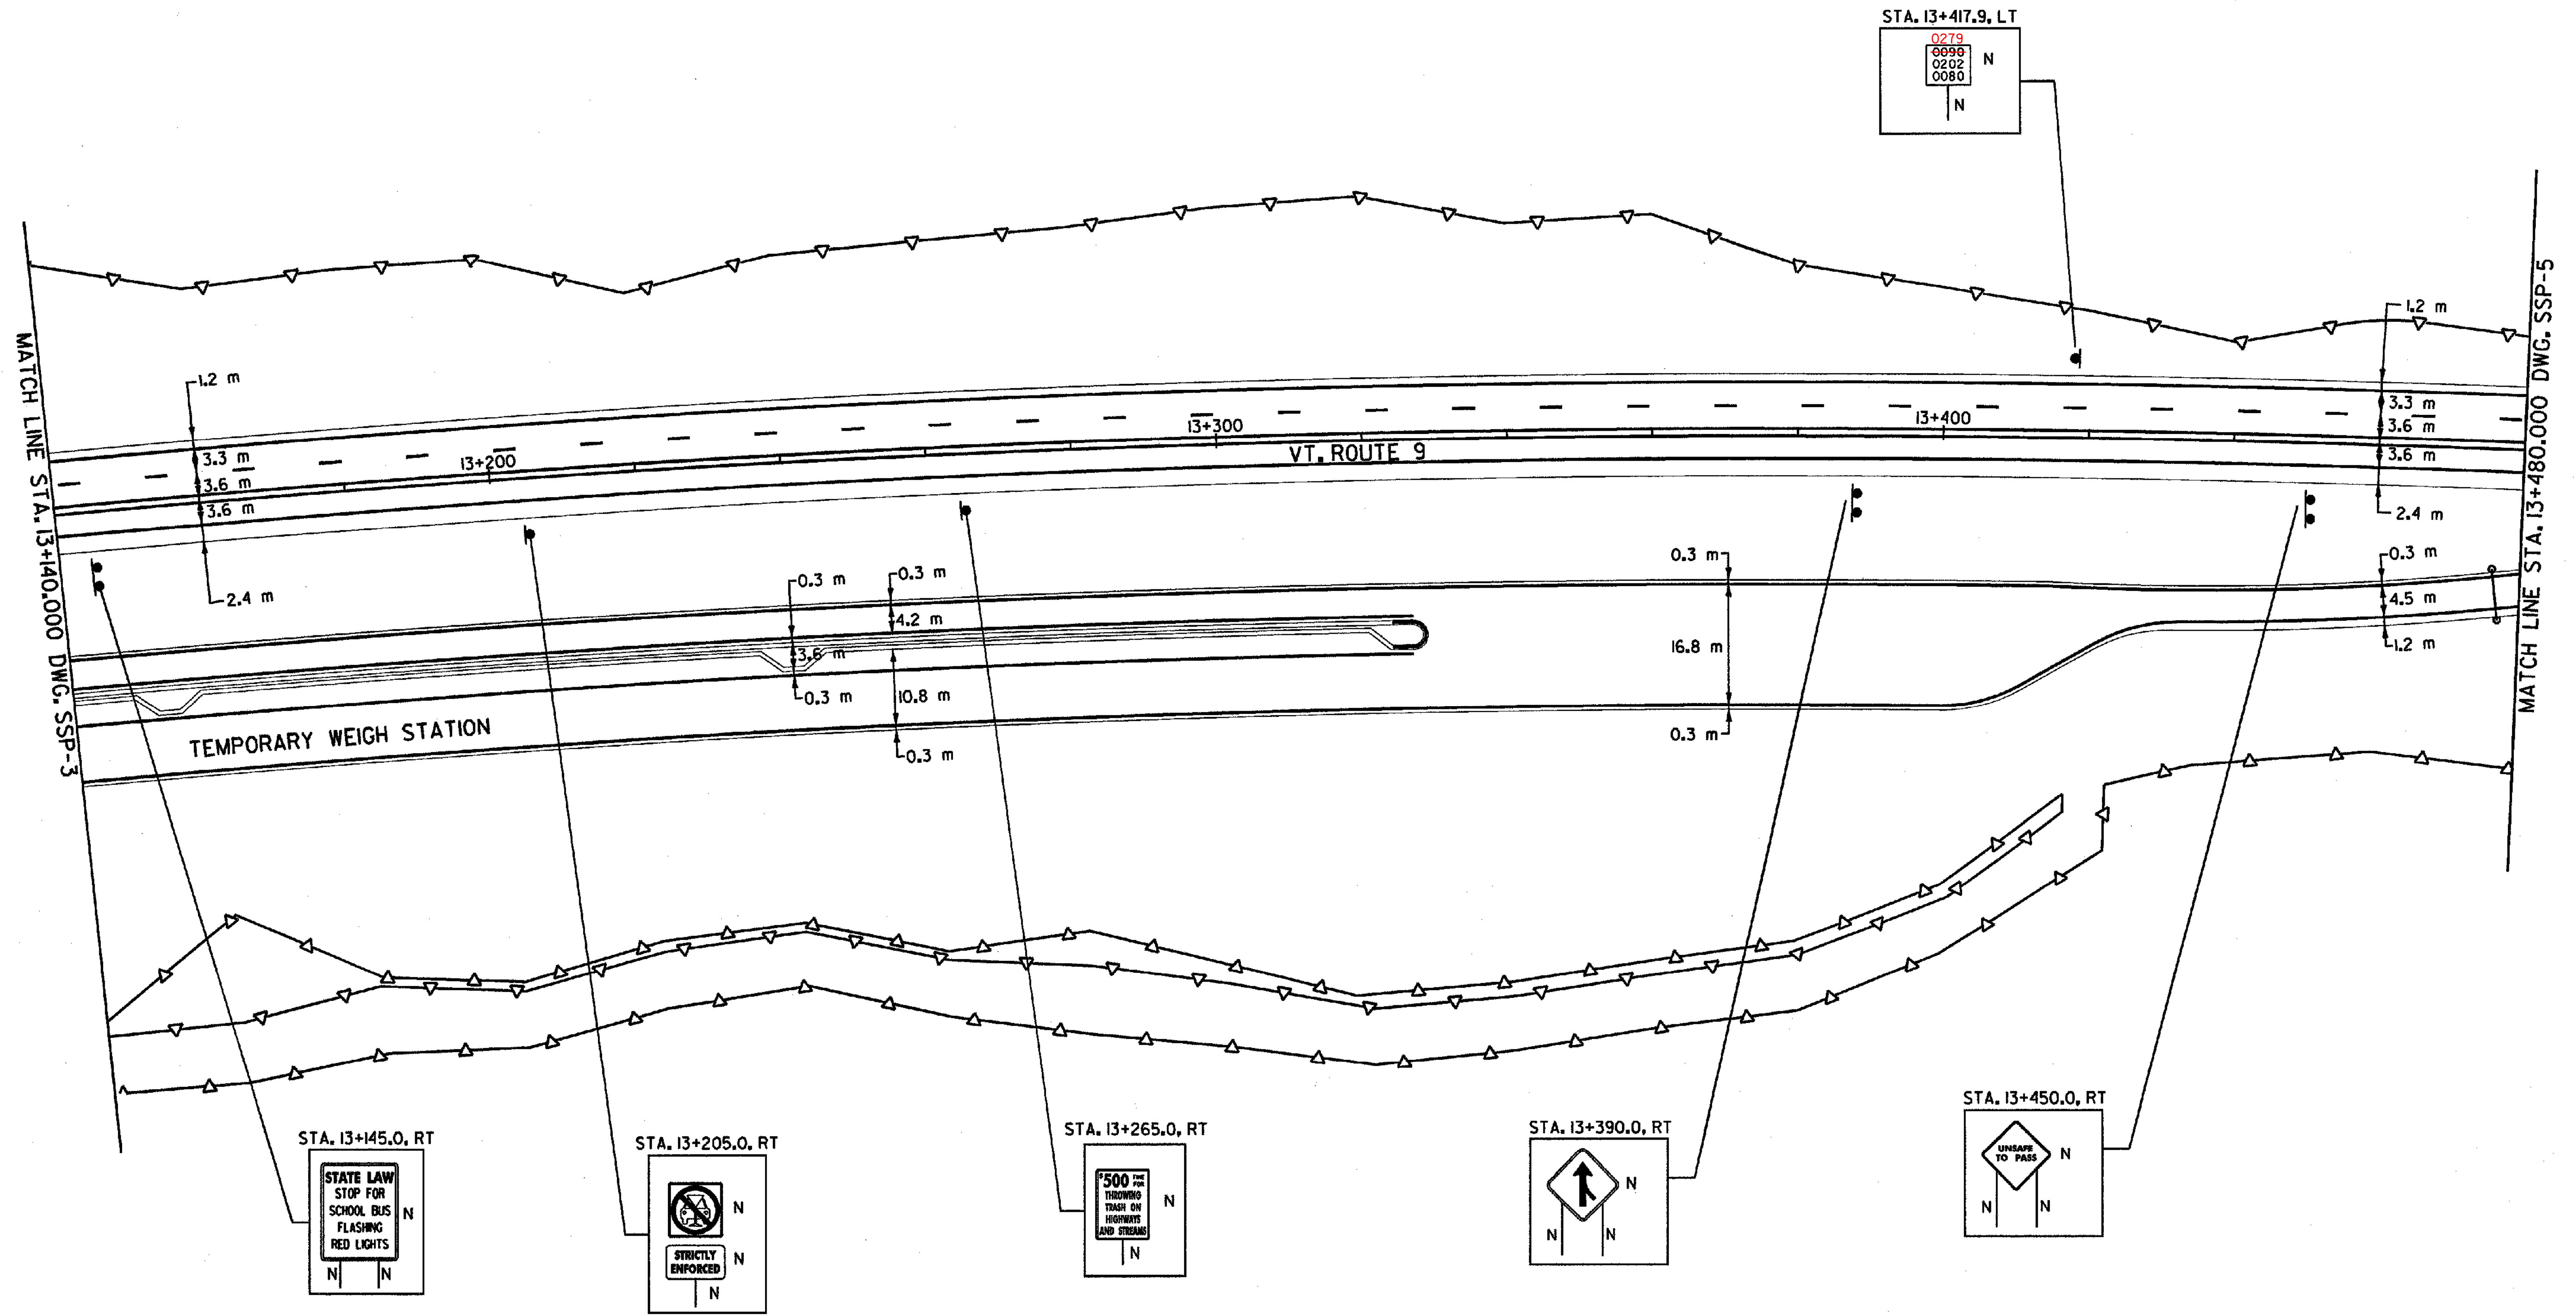


150  
 646.40 DURABLE 100 mm WHITE LINE  
 STA. 13+140.000 - STA. 13+480.000 SOLID LT & RT (EDGE LINE)  
 STA. 13+140.000 - STA. 13+480.000 DASHED 3.6 m LT (LANE LINE)  
 STA. 13+140.000 - STA. 13+480.000 SOLID RT (EDGE LINE)  
 STA. 13+140.000 - STA. 13+326.600 SOLID RT (RAISED ISLAND EDGE LINES)


150  
 646.41 DURABLE 100 mm YELLOW LINE  
 STA. 13+140.000 - STA. 13+480.000 DOUBLE SOLID (CENTER LINE)  
 STA. 13+140.000 - STA. 13+480.000 SOLID RT (EDGE LINE)

646.81 PAINTED CURB (YELLOW)  
 STA. 13+323.4 - STA. 13+328.4 RT (RAISED ISLAND NOSE)

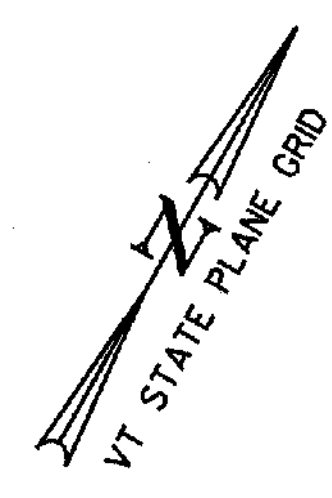

FILE NAME = \\S:\5116\VAOT\CONTRACT3\VTSSP9A.dgn  
 DATE/TIME = 10/16/2001  
 USER = 664

DATUM	
VERTICAL	NAVD 88
HORIZONTAL	NAD 83 (1992)

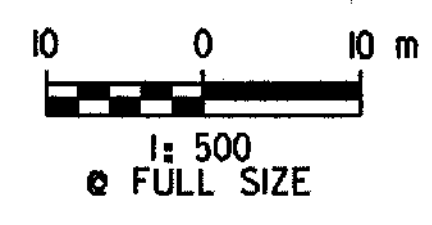

**SIGN LEGEND**  
 R = REMOVE  
 S = SALVAGE  
 N = NEW  
 RET = RETAIN  
 B-B = BACK TO BACK  
 EXISTING = -----  
 NEW = \_\_\_\_\_

## SIGNING AND STRIPING PLAN

AS-BUILT NOTE: SEE NOTE ON SHEET 144

SURVEYED BY	C.H.A. & V.S.E.	DATE	12/93
DESIGNED BY	D.E.G.	DATE	11/01
DRAWN BY	J.S.L.	DATE	11/01
CHECKED BY	T.P.K.	DATE	11/01
DESIGN FILE NO.	/5116/VAOT/VTSSP9		
PROJ. NAME	BENNINGTON - HOOSICK D.P.L. 0146(1) C/3		
PROJ. NO.	P.I.N. 1306.60		
DWG NO. SSP-4	SHEET 147 OF 473		