


646.40 DURABLE 150 mm WHITE LINE
 STA. 15+200.000 - STA. 15+560.000 SOLID LT & RT (EDGE LINE)


646.41 DURABLE 150 mm YELLOW LINE
 STA. 15+200.000 - STA. 15+280.000 DASHED LT/SOLID RT (CENTER LINE)
 STA. 15+280.000 - STA. 15+560.000 DOUBLE SOLID (CENTER LINE)

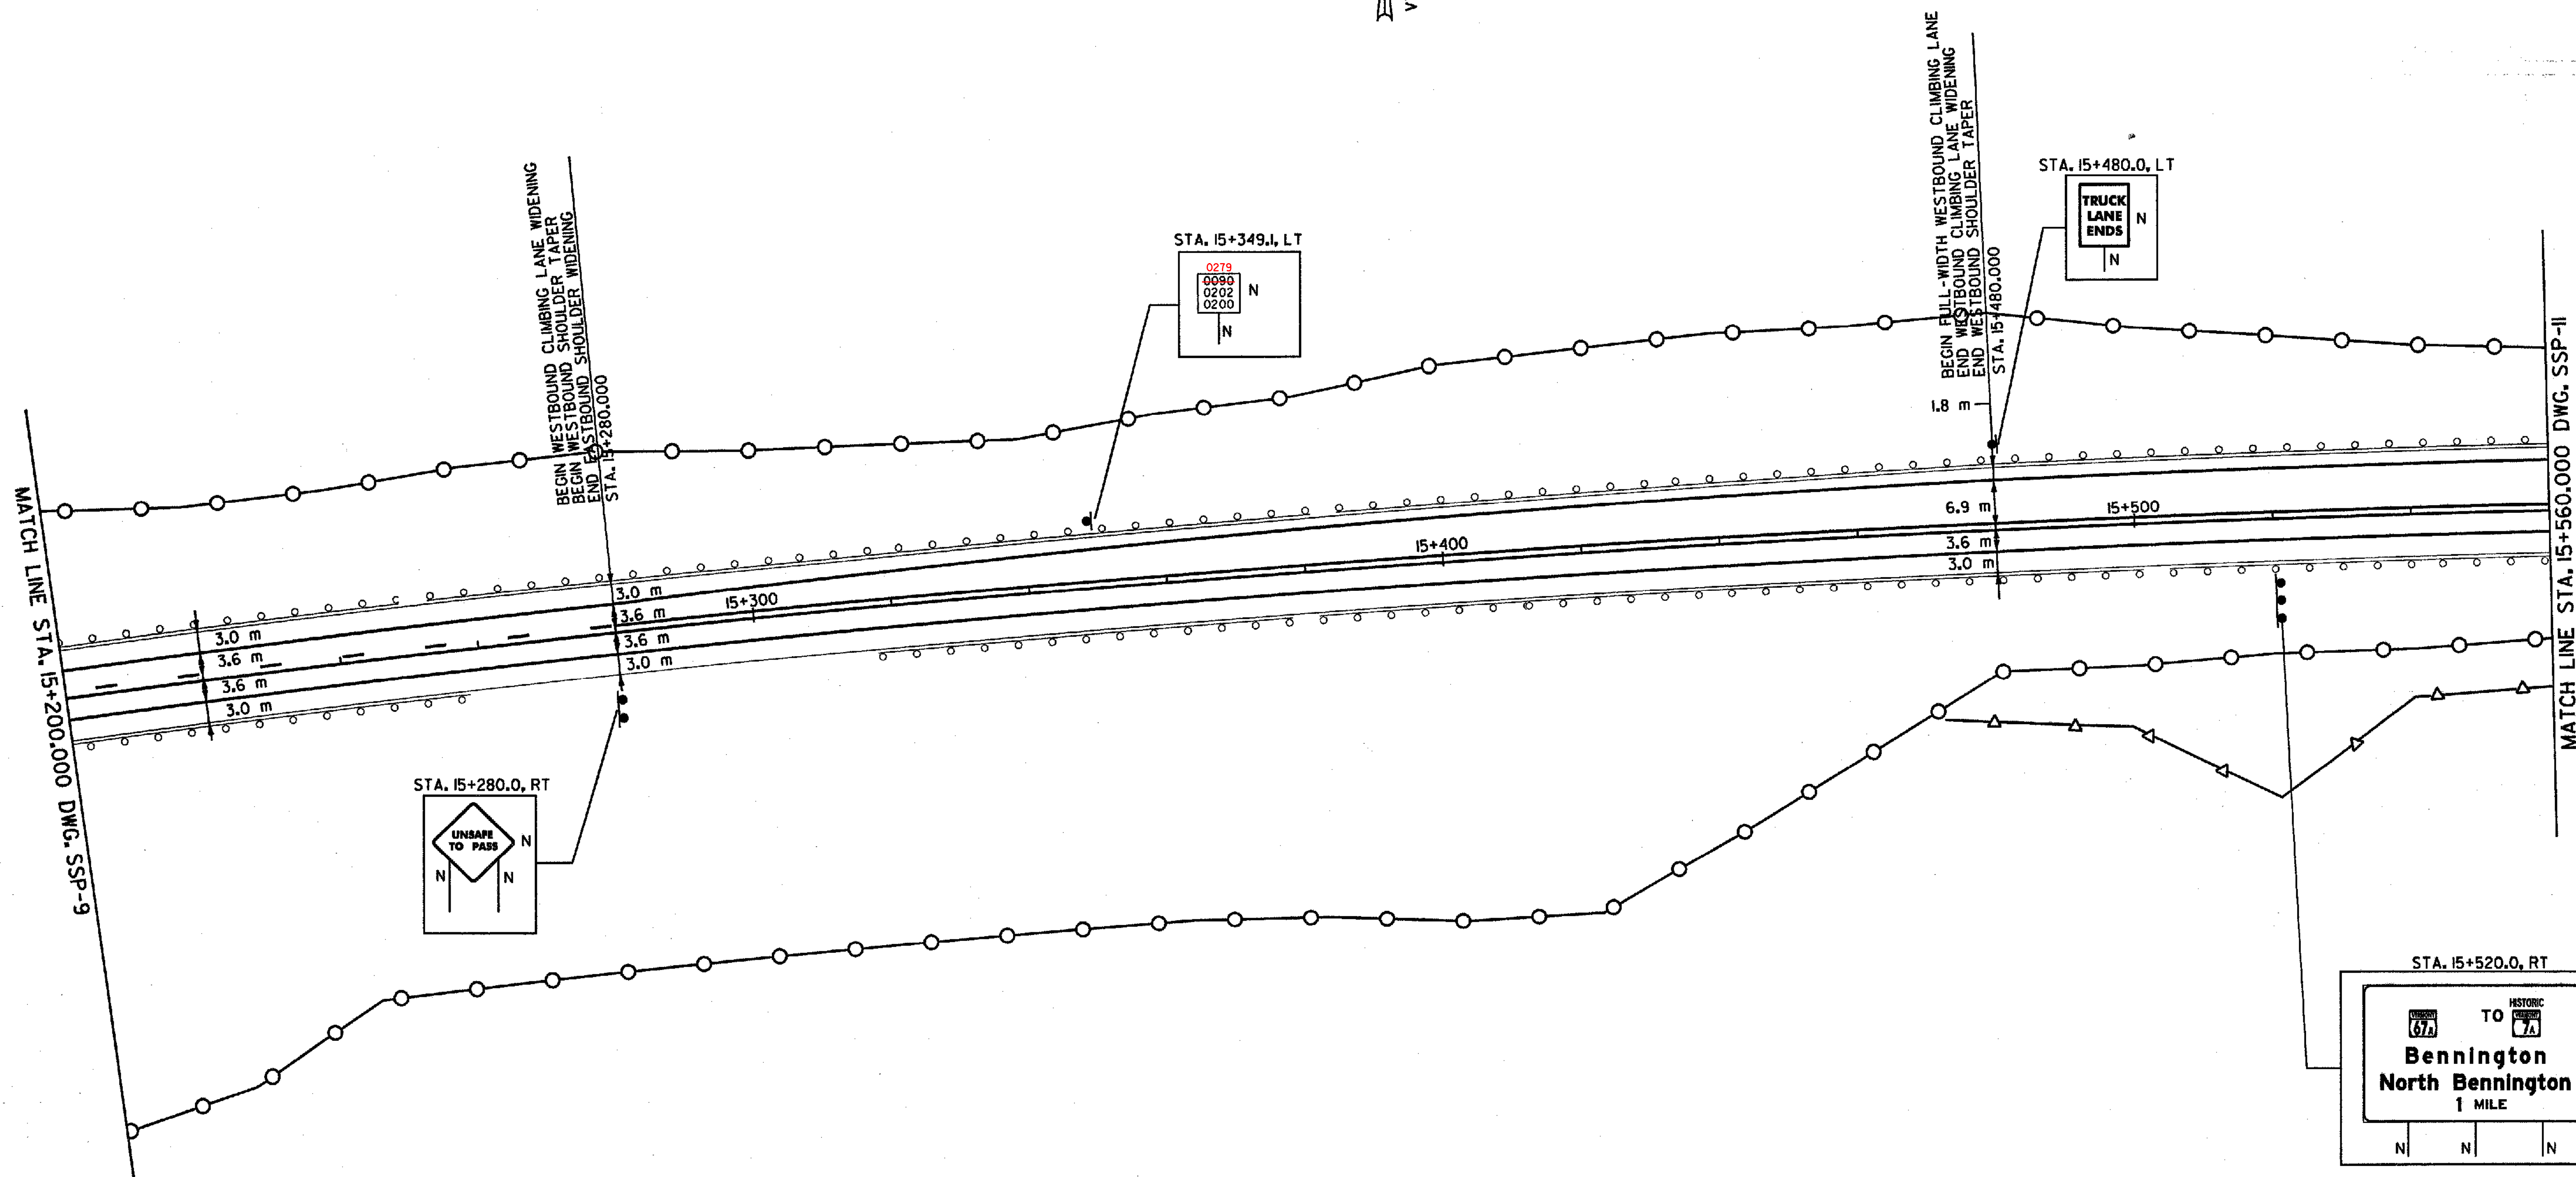

FILE NAME = J:\S16\VAOT\CONTRACT\VTSSP12A.dgn
 DATE/TIME = 10/11/2001
 USER = B64

DATUM	
VERTICAL	NAVD 88
HORIZONTAL	NAD 83 (1992)

SIGN LEGEND
 R = REMOVE
 S = SALVAGE
 N = NEW
 RET = RETAIN
 B-B = BACK TO BACK
 EXISTING =
 NEW =

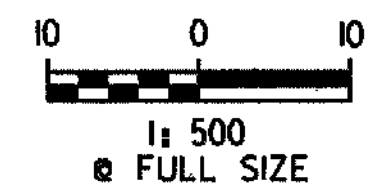

AS-BUILT NOTE: SEE NOTE ON SHEET 144
 RMT 2/3/06

SIGNING AND STRIPING PLAN

SURVEYED BY	C.H.A. & V.S.E.	DATE	12/93
DESIGNED BY	D.E.G.	DATE	11/01
DRAWN BY	J.S.L.	DATE	11/01
CHECKED BY	T.P.K.	DATE	11/01
DESIGN FILE NO.	/S16/VAOT/VTSSP12		
PROJ. NAME	BENNINGTON - HOOSICK D.P.L. 0146(1) C/3		
PROJ. NO.	P.L.N. 1306.60		
DWG NO. SSP-10	SHEET 153 OF 473		