



PLAN
1:50
AS PL.

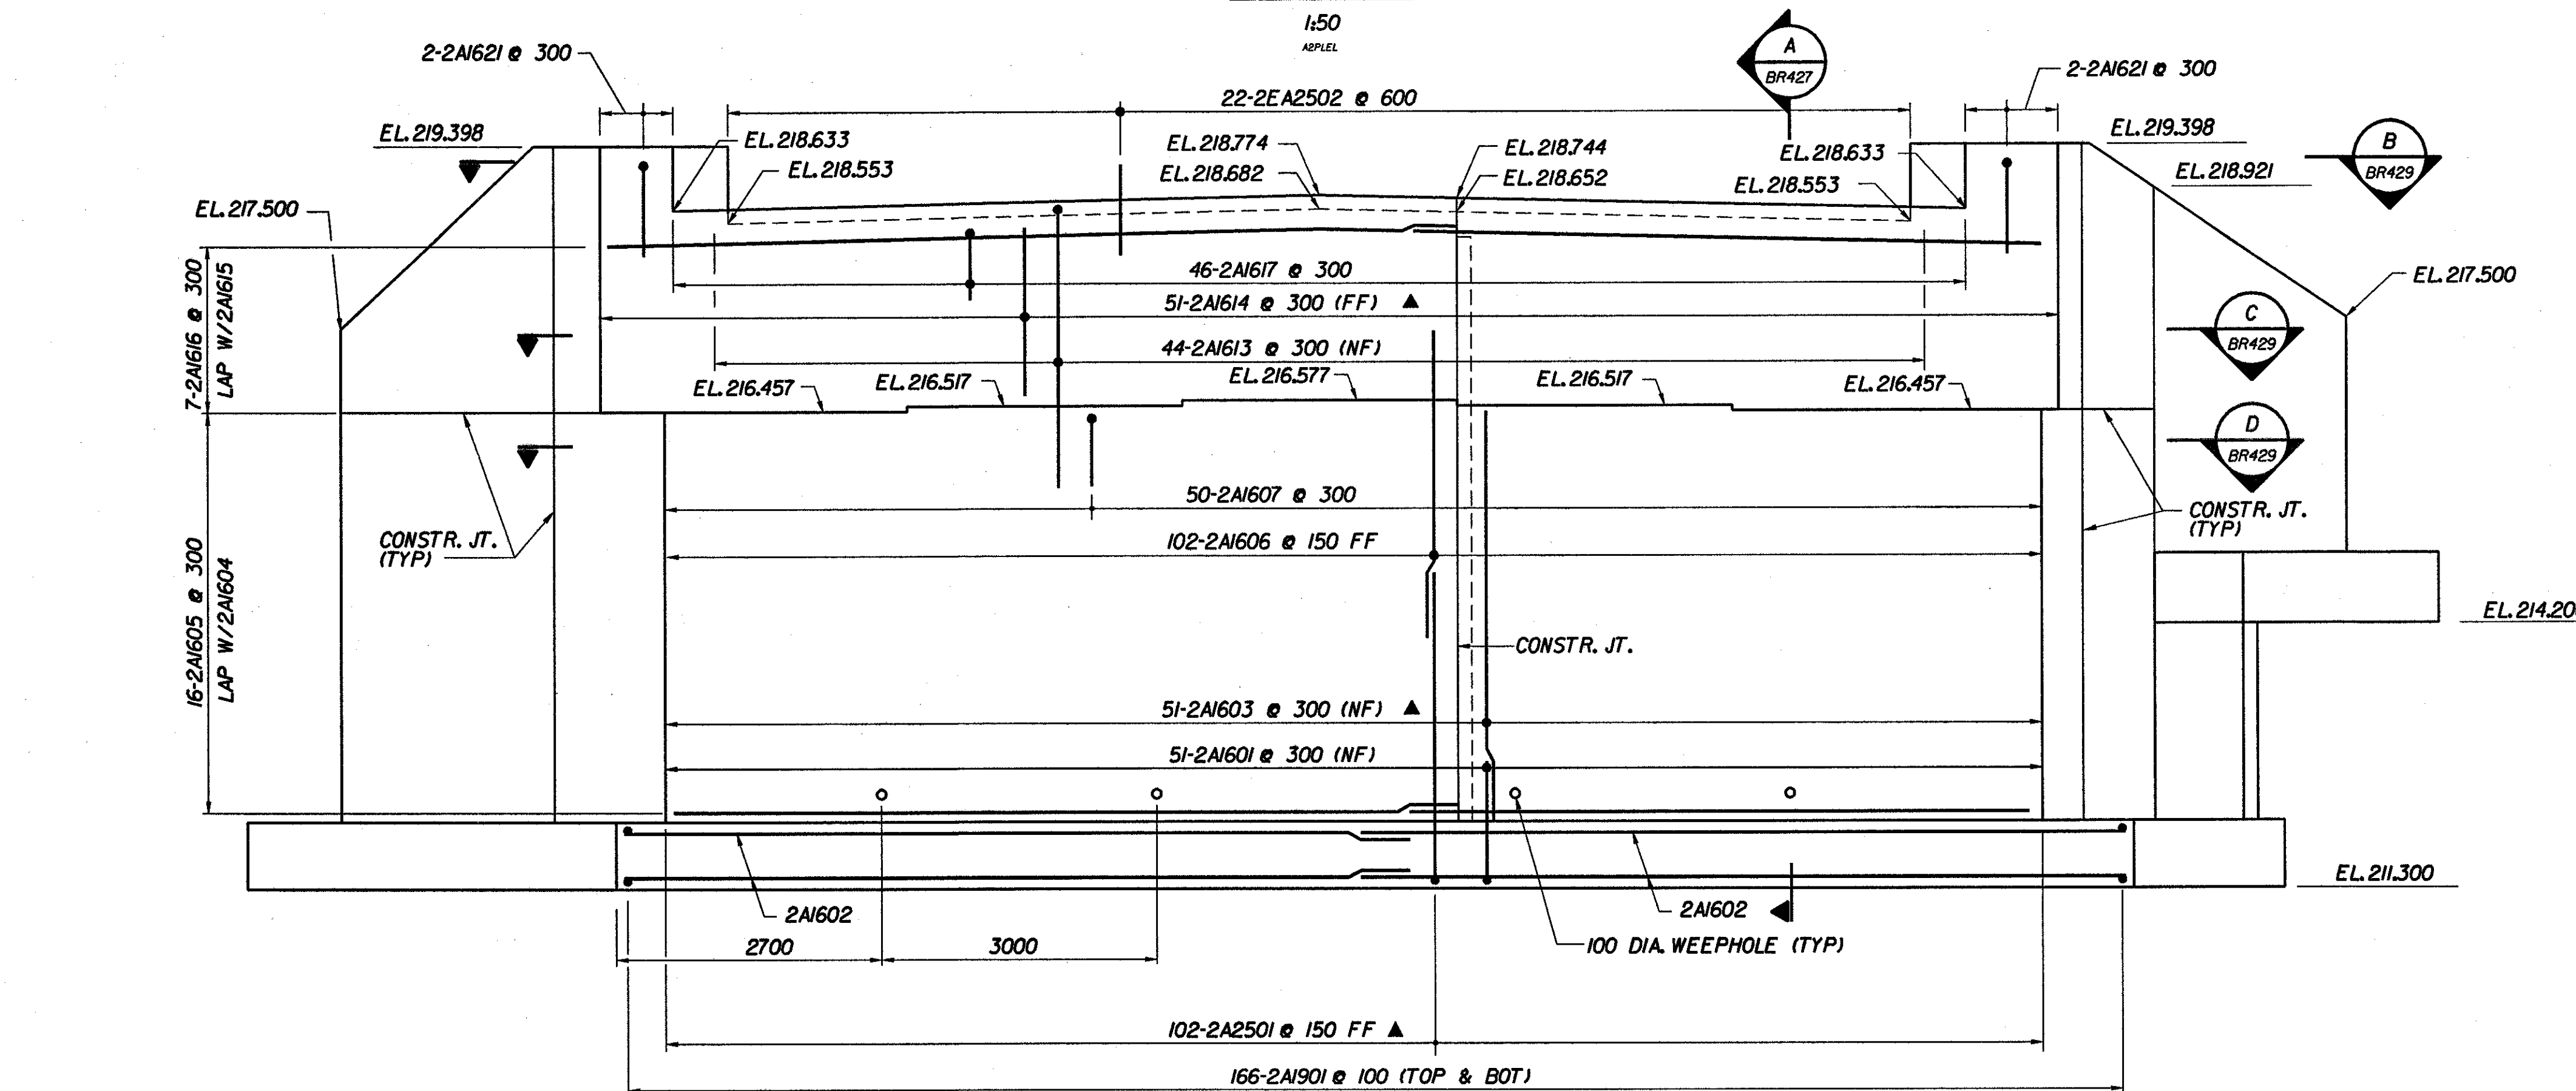

ELEVATION
1:50
AS PL.

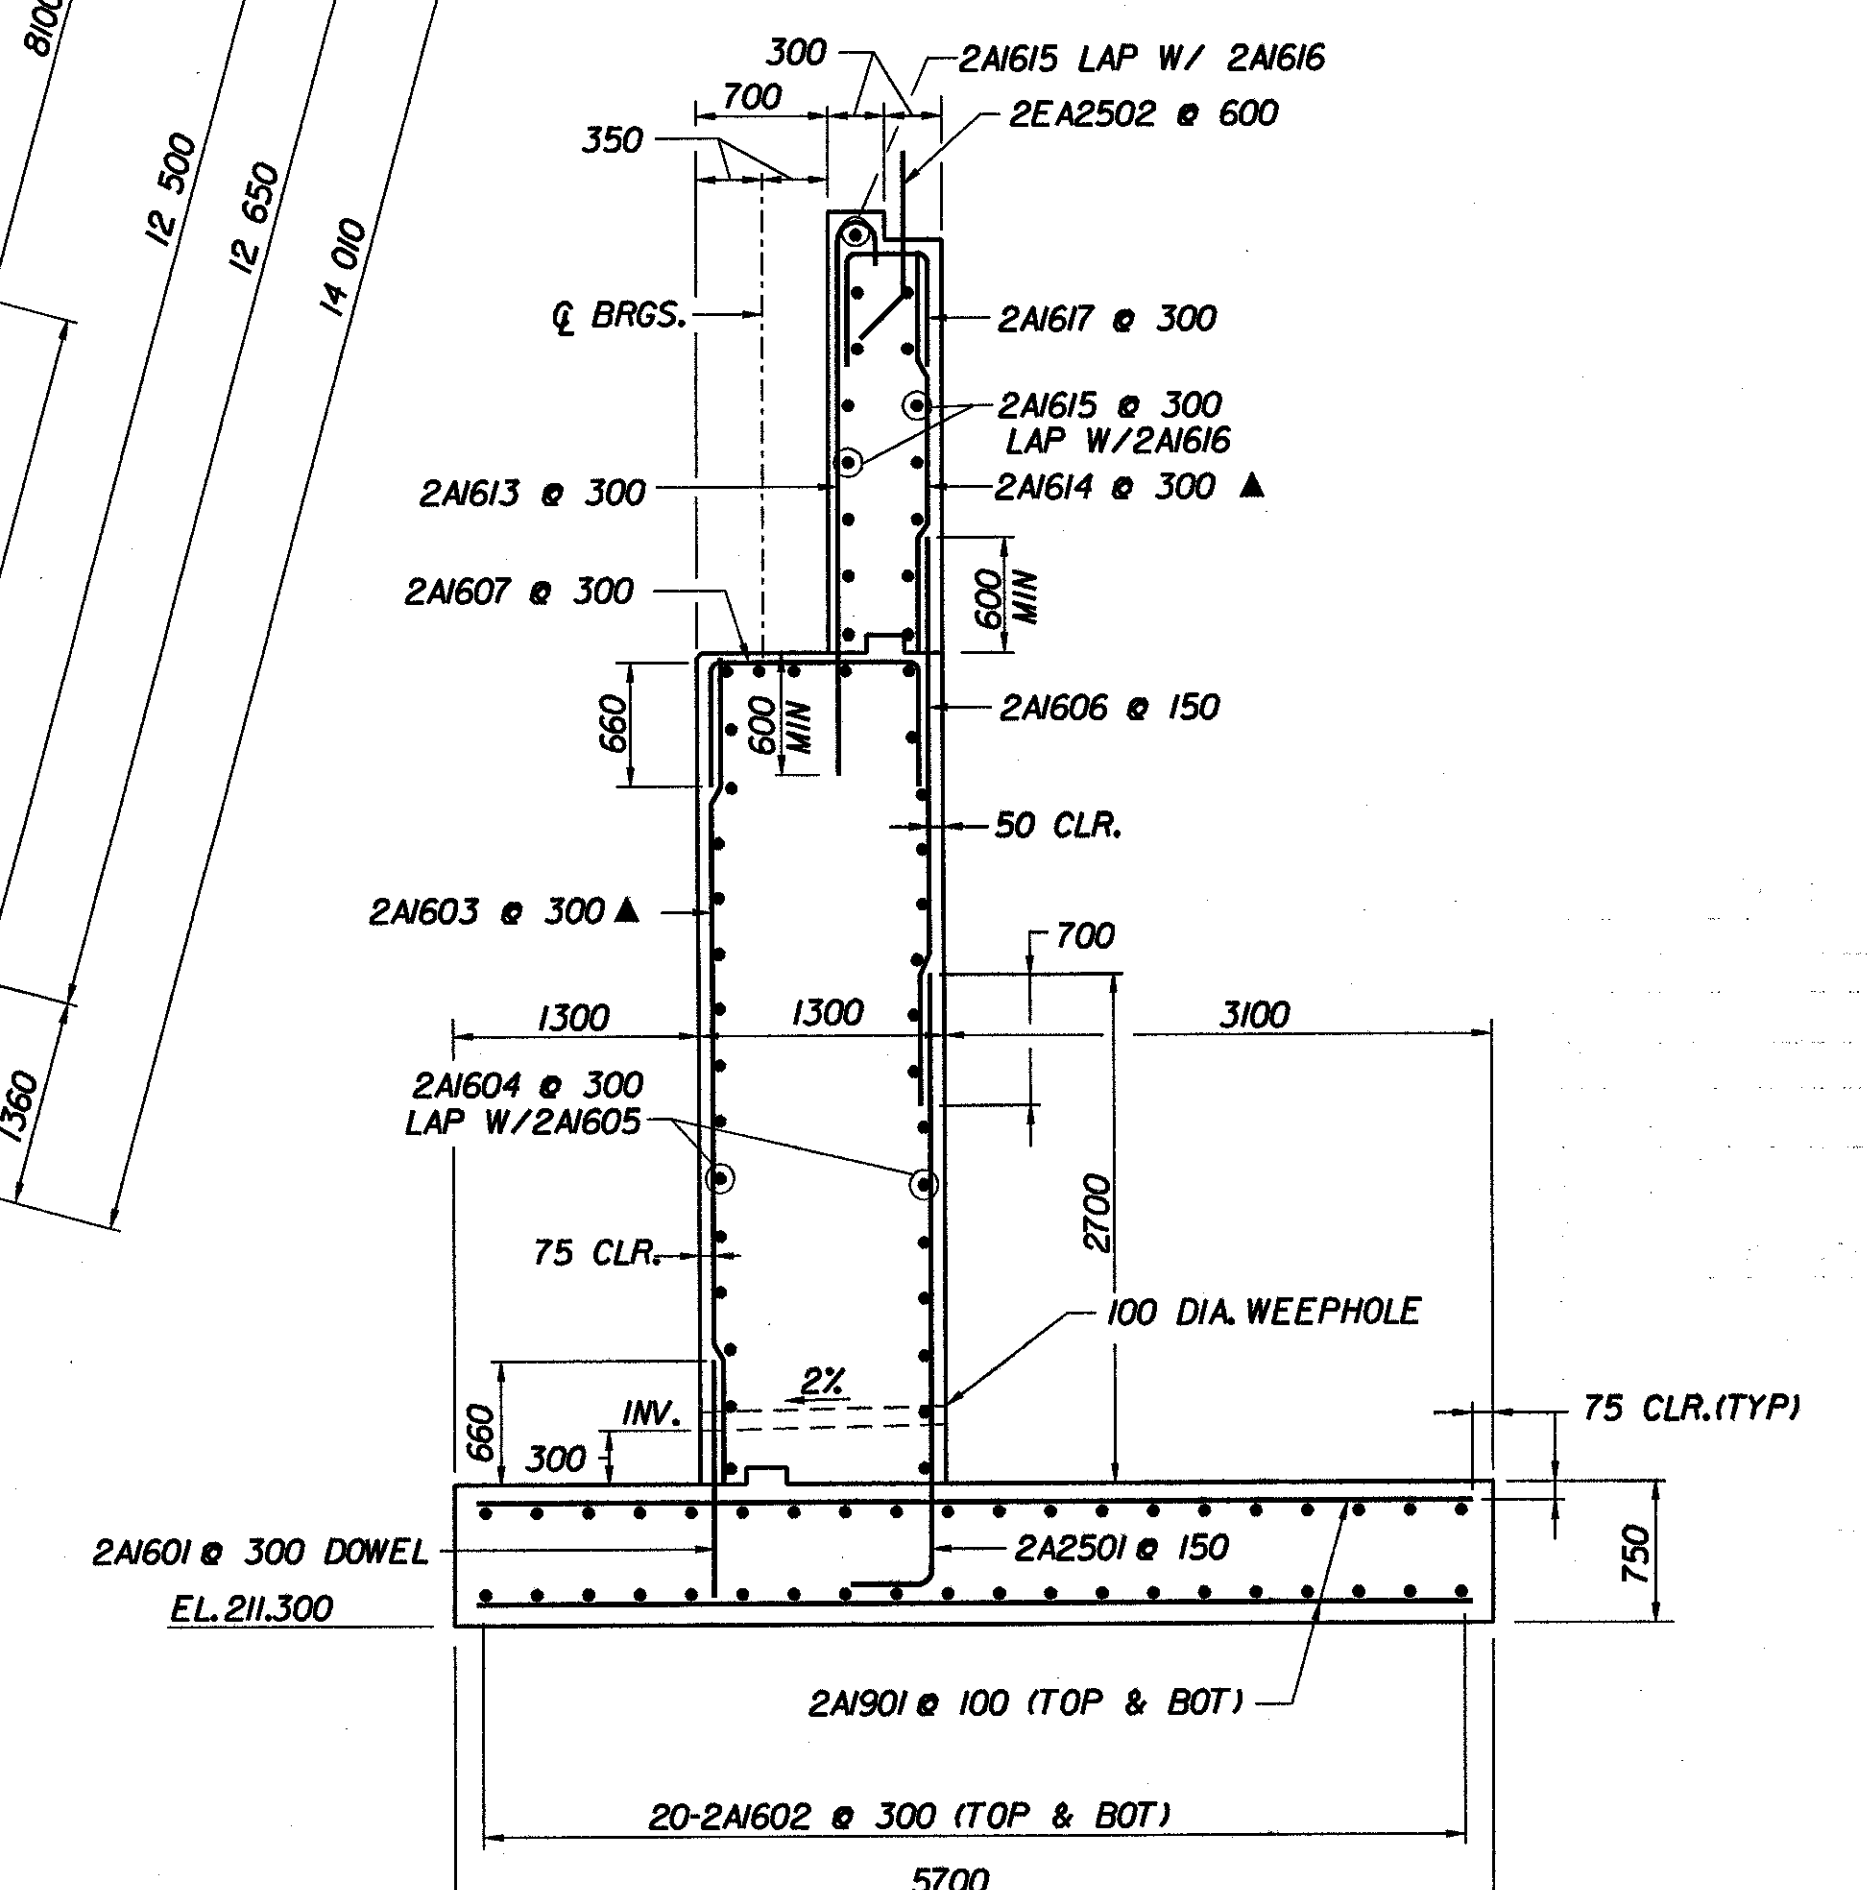

ABUTMENT SECTION
1:40
AS SECT.

- NOTES:**
- NF DENOTES NEAR FACE
FF DENOTES FAR FACE
EF DENOTES EACH FACE
 - FOR WEEPHOLE DETAILS, SEE SHEET BR429.
 - ▲ INDICATES BARS TO FIELD CUT.

STATE OF VERMONT AGENCY OF TRANSPORTATION	
Town Of BENNINGTON	Bridge No. BR400
Highway No. VT, RTE. 9	Log Sta. 14+140
VT, RTE. 9 OVER AIRPORT BROOK WEST	
ABUTMENT 2 PLAN, ELEVATION & SECTION	
Designed By M. GOGUEN	Drawn by B. WEATHERBY/K. DETRICK
Checked By P. PERKINS 11/01	Bridge Design Supervisor M. OLSTAD Date 11/01
PROJECT BENNINGTON-HOOSICK	PROJECT NO. D.P.J. 0146(1)
I.G.C. Info.	
Bridge Sheet No. BR427	Sheet 216 OF 473

FILE NAME: s:\3573\15\br427\2014\br427.plt
 DATE/TIME: 10/11/2011 10:58:44
 USER: rbb4

