


<b>STATE OF VERMONT AGENCY OF TRANSPORTATION</b>	
Town Of <b>BENNINGTON</b>	Bridge No. <b>BR400</b>
Highway No. <b>VT. RTE. 9</b>	Log Sta. <b>Surv. Sta. 14+140</b>
<b>VT. RTE. 9 OVER AIRPORT BROOK WEST</b>	
<b>TYPICAL DETAILS</b>	
Designed By <b>I. LIONG</b>	Drawn By <b>I. LIONG</b>
Checked By <b>L. CLAY/M. MACARELLI</b>	Bridge Design Supervisor <b>Date</b>
PROJECT <b>BENNINGTON-HOOSICK</b>	PROJECT NO. <b>D.P.I. 0146(1) C/3</b>
I.G.C. Info.	
Bridge Sheet No. <b>BR432</b>	Sheet <b>221</b> of <b>473</b>

CERTIFIED FOR INTERNAL STABILITY OF RETAINED EARTH™ STRUCTURES ONLY. EXTERNAL STABILITY, INCLUDING BUT NOT LIMITED TO FOUNDATION AND SLOPE STABILITY, IS THE RESPONSIBILITY OF THE OWNER. DESIGN IS BASED ON THE ASSUMPTION THAT THE MATERIAL WITHIN THE RETAINED EARTH™ MASS, METHODS OF CONSTRUCTION, AND QUALITY OF PREFABRICATED MATERIALS CONFORM TO THE MANUFACTURER'S SPECIFICATION.

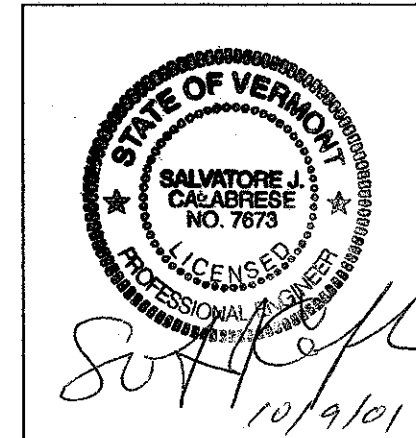

Foster Geotechnical claims a strict proprietary right in all drawings, specifications and calculations ("information") set forth on this sheet. The use of such information in whole or in part, or any reproduction thereof, is restricted to the site for which it was prepared and to the material and/or service provided by Foster Geotechnical. Any other use is strictly prohibited, and Foster Geotechnical disclaims any LIABILITY THEREFOR.

**FOSTER-GEOTECHNICAL**  
A Division of L. B. Foster Company  
1372 Old Bridge Road, Suite 101, Woodbridge, VA 22192  
Telephone: (703) 499-9818 / Fax: (703) 499-9348  
SAN DIEGO, CA / WOODBRIDGE, VA / NORCROSS, GA