
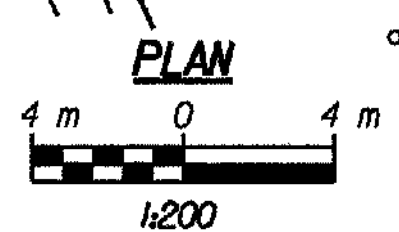


**VT.RTE.9
CURVE W.B.G. DATA**
 P.C. STA. 14+424.255
 P.C.C. STA. 15+308.571
 $\Delta = 20^\circ 53' 37.8''$ RT.
 R = 2425.000 m
 T = 447.24 m
 L = 884.316 m
 E = 40.876 m
 e MAX. = 0.022 DN RT

NOTE: UNLESS NOTED OTHERWISE, ALL STATIONS ARE IN KILOMETERS, ALL ELEVATIONS ARE IN METERS, AND ALL DIMENSIONS ARE IN MILLIMETERS.

LIST OF BRIDGE SHEETS	
SHEET NO.	DESCRIPTION
BR500	PLAN AND ELEVATION
BR501	PRELIMINARY INFORMATION
BR502	GENERAL NOTES
BR503	BRIDGE QUANTITY SHEET
BR504	BORING LOCATION PLAN
BR505	SOIL BORING LOGS
BR506	SOIL BORING LOGS
BR507	SOIL BORING LOGS
BR508	SOIL BORING LOGS
BR509	TYPICAL BRIDGE SECTION
BR510	DECK REINFORCEMENT & RAILING PLAN
BR511	FRAMING PLAN
BR512	CROSSFRAME DETAILS
BR513	GIRDER ELEVATION
BR514	GIRDER DETAILS
BR515	SPLICE DETAILS
BR516	ELASTOMERIC BEARING DETAILS
BR517	BRIDGE JOINT DETAILS - 1
BR518	BRIDGE JOINT DETAILS - 2
BR519	BRIDGE JOINT DETAILS - 3
BR520	BRIDGE JOINT DETAILS - 4
BR521	APPROACH SLAB DETAILS
BR522	CURB DETAILS
BR523	ABUTMENT 1 PLAN AND ELEVATION
BR524	ABUTMENT 2 PLAN AND ELEVATION
BR525	ABUTMENTS 1 & 2 FOOTING DETAILS
BR526	ABUTMENT 1 DETAILS
BR527	ABUTMENT 2 DETAILS
BR528	MSE WALL - NOTES
BR529	MSE WALLS - PLAN AND SECTIONS
BR530	MSE WALL - PANEL DETAILS
BR531	REINFORCING STEEL SCHEDULE - 1


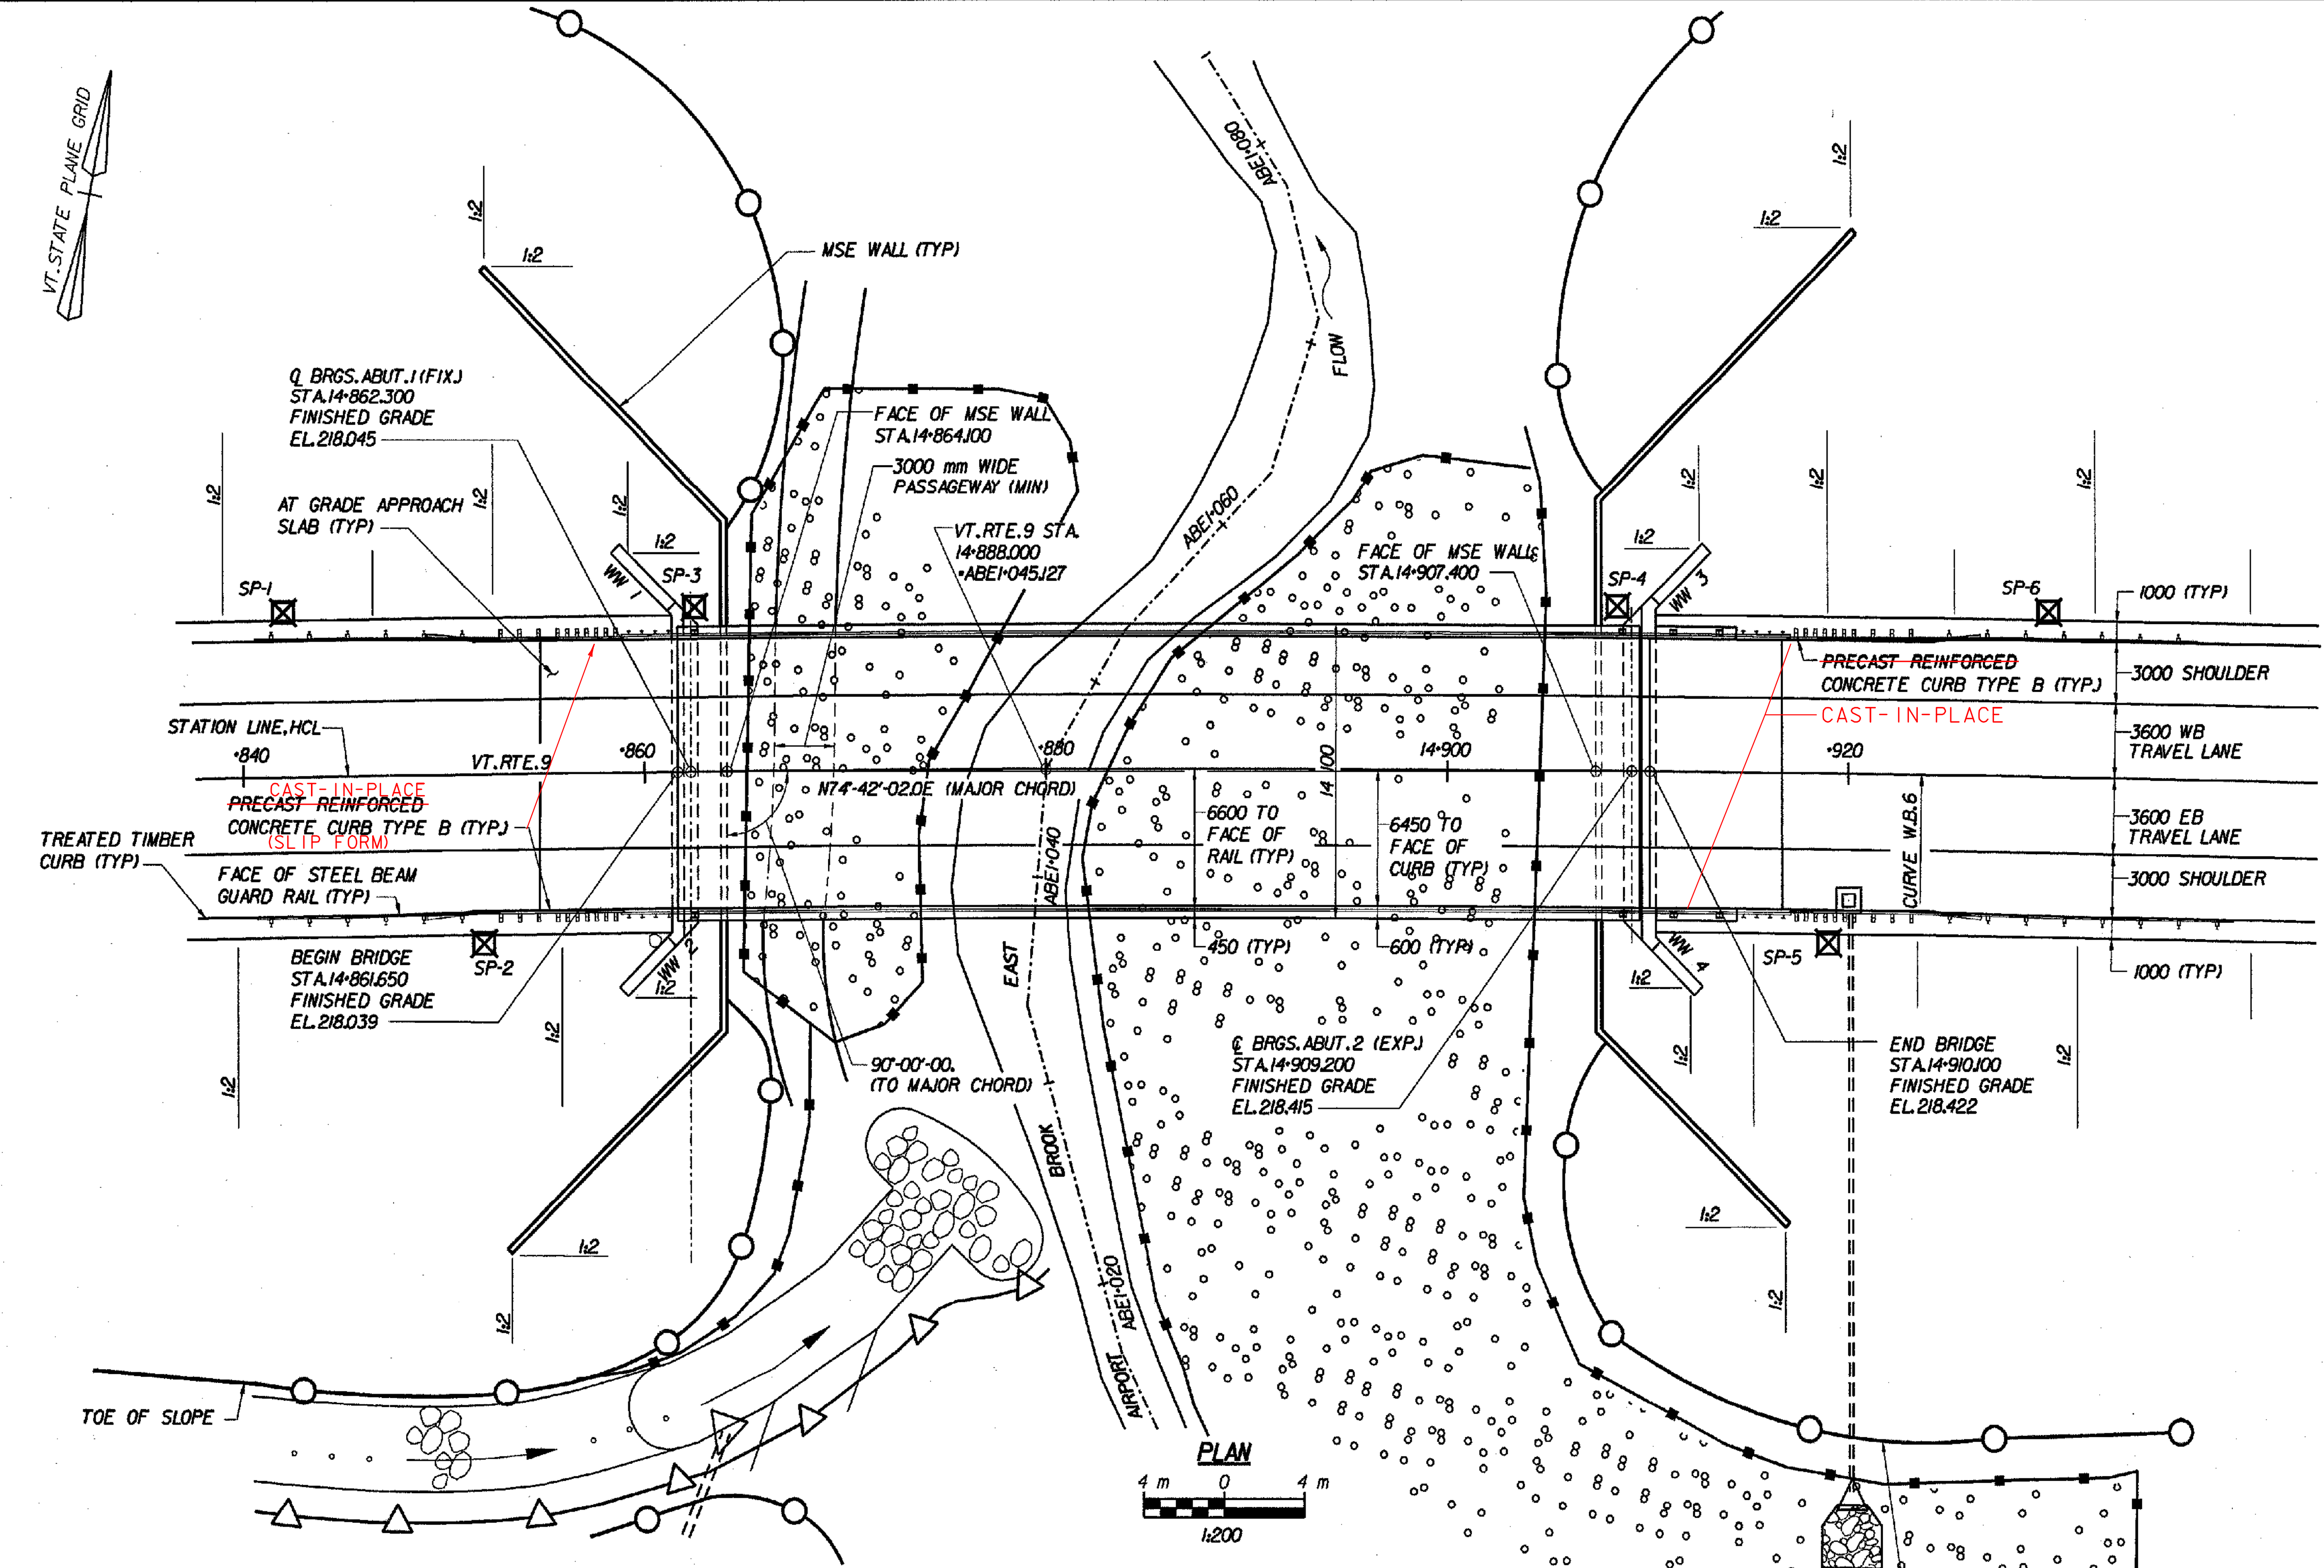


LEGEND:

- INDICATES TEMPORARY CONSTRUCTION ACCESS/WORK AREAS
- INDICATES LIMITS OF SILT FENCE
- SP-6 INDICATES LOCATION OF SETTLEMENT PLATFORM

SETTLEMENT PLATFORM SCHEDULE:

STATION	OFFSET
SP-1 (TYPE 1) 14+842	8m LT.
SP-2 (TYPE 1) 14+852	8m RT.
SP-3 (TYPE 1) 14+862.5	8m LT.
SP-4 (TYPE 1) 14+908.5	8m RT.
SP-5 (TYPE 1) 14+918	8m RT.
SP-6 (TYPE 1) 14+930	8m LT.

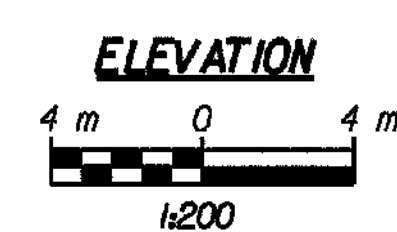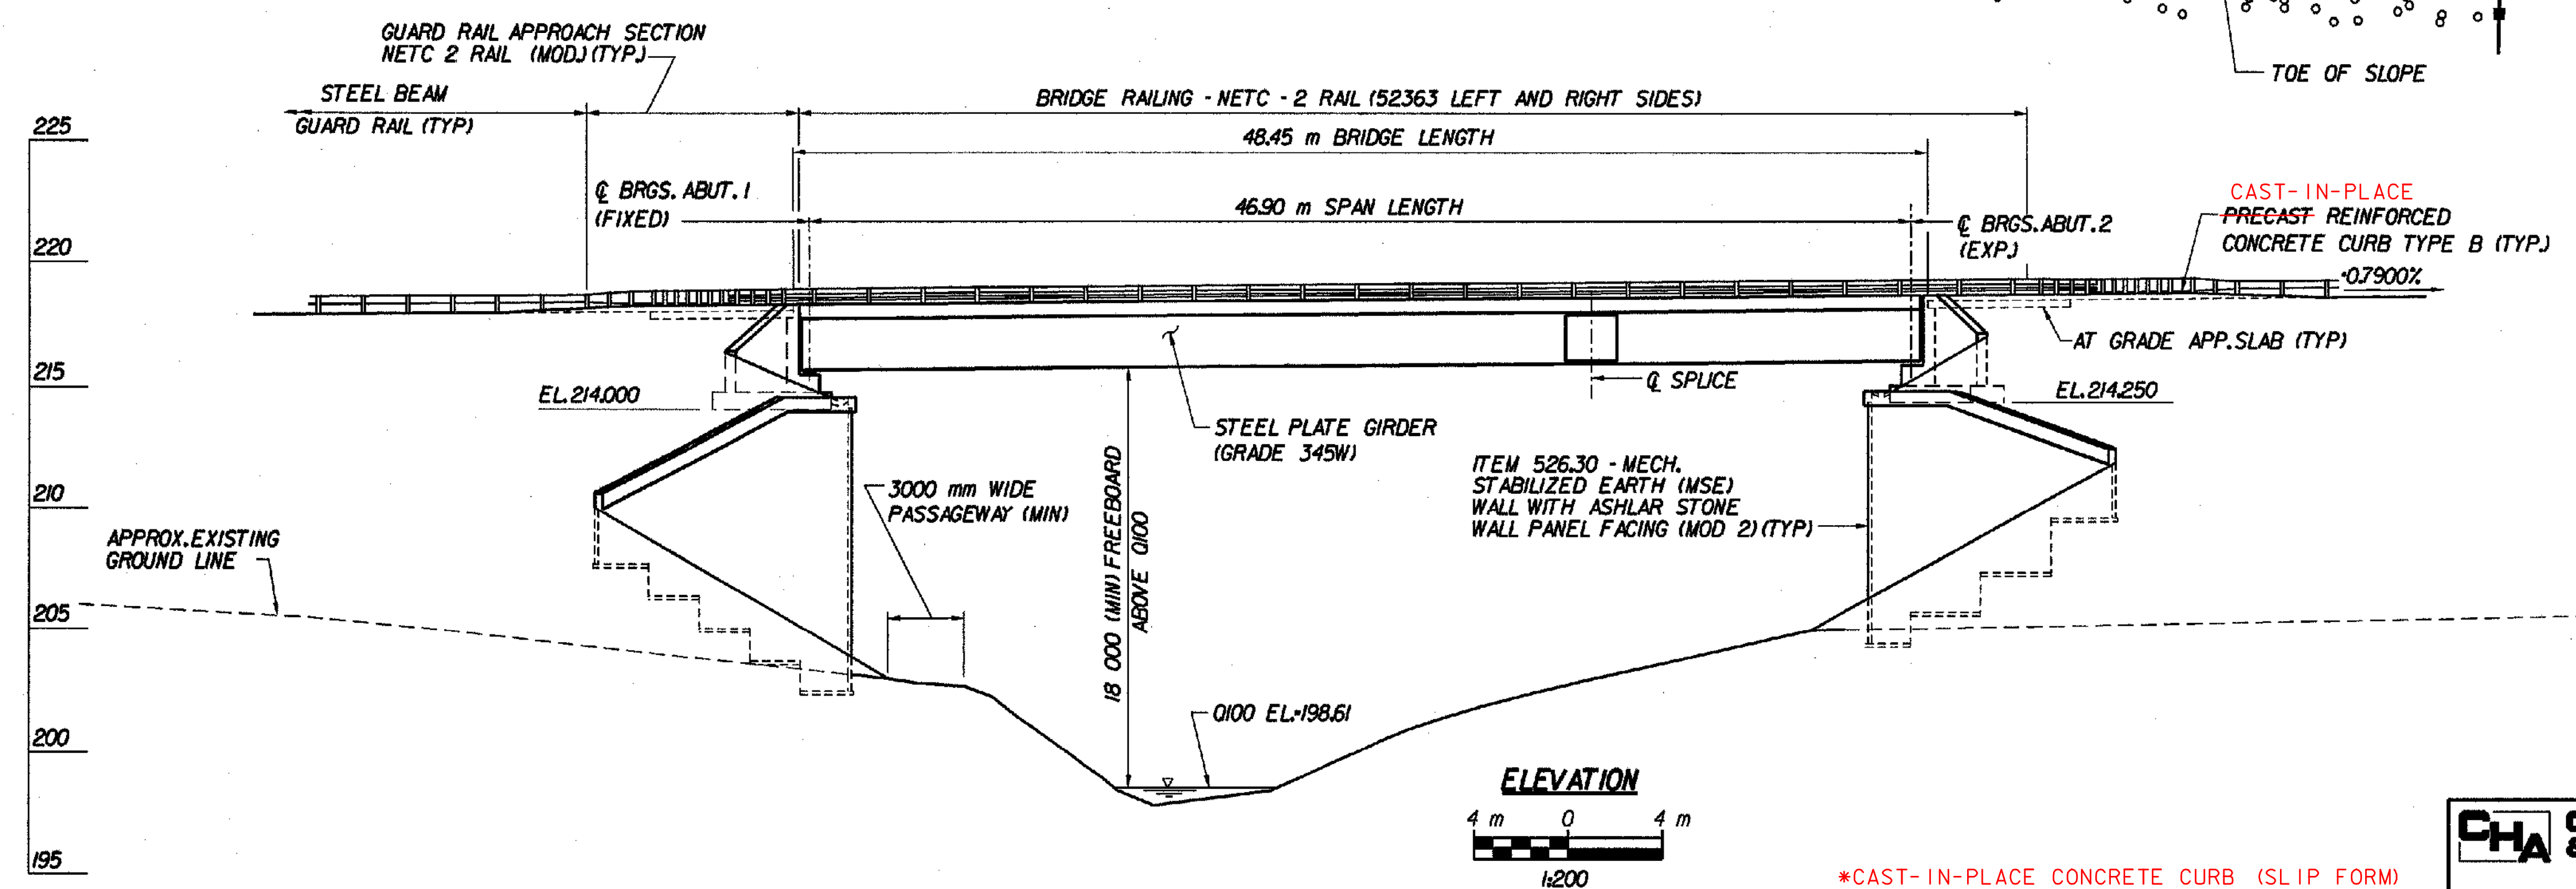

*CAST-IN-PLACE CONCRETE CURB (SLIP FORM)
JFW 2/2/06



**STATE OF VERMONT
AGENCY OF TRANSPORTATION**

Town Of	BENNINGTON	Bridge No.	BR500
Highway No.	VT. RTE. 9	Log Sta.	
		Surv. Sta.	14+900
VT. RTE. 9 OVER AIRPORT BROOK EAST			
PLAN AND ELEVATION			
Designed By	M. GOGUEN	Drawn by	B. WEATHERBY
Checked By	Date	Bridge Design Supervisor	Date
	P. PERKINS 11/01	M. OLSTAD	11/01
PROJECT	BENNINGTON-HOOSICK		PROJECT NO.
			D.P.J. 0146(1)
I.G.C. Info.			
Bridge Sheet No.	BR500	Sheet	230 OF 473

FILE NAME = 14-3573\15-15-06-508-508-pla1.plt
 DATE/TIME = 10/11/2001
 USER = bcc