


U TYPICAL ABUTMENT CONN. PLATES AND BEARING STIFFENERS
BR511

W INTERIOR CONNECTION PLATES AND LATERAL CONN. PLATES
BR511

Y INTERIOR LATERAL CONN. PLATES
BR511

TYPICAL CONNECTIONS

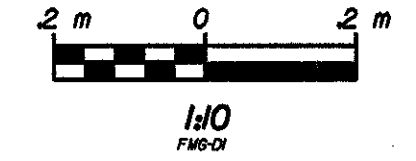

- NOTES:**
1. FOR STRUCTURAL STEEL NOTES, SEE SHT. BR513.
 2. FOR CROSSFRAME DETAILS, SEE SHT. BR512.
 3. FOR GIRDER ELEVATION AND DETAILS, SEE SHT. BR513.

STATE OF VERMONT AGENCY OF TRANSPORTATION	
Town of BENNINGTON	Bridge No. BR500
Highway No. VT. RTE. 9	Log Sta. 14+900
VT. RTE. 9 OVER AIRPORT BROOK EAST	
FRAMING PLAN	
Designed By M. GOGUEN	Drawn by B. WEATHERBY
Checked By P. PERKINS 11/01	Bridge Design Supervisor M. OLSTAD Date 11/01
PROJECT BENNINGTON-HOOSICK	PROJECT NO. D.P.J. 0146(1)
I.G.C. Info.	
Bridge Sheet No. BR511	Sheet 241 OF 473