


STATE OF VERMONT	
AGENCY OF TRANSPORTATION	
Bridge No. BR500	Town of BENNINGTON
Log Sta.	Highway No. VT, RTE. 9
Surv. Sta. 14+900	VT, RTE. 9 OVER AIRPORT BROOK EAST
CROSSFRAME DETAILS	
Designed By M. GOGUEN	Drawn by B. WEATHERBY
Checked By P. PERKINS II/OI	Bridge Design Supervisor
Date	M. O. L. STAD
PROJECT	BENNINGTON-HOOSICK
D.P.L. 0146111	
I.G.C. Info.	
Bridge Sheet No. BR512	
Sheet 242 OF 473	



NOTE:  
 ALL CONNECTIONS SHALL BE MADE USING M22  
 DIAMETER AASHTO M16M BOLTS. ALL HOLES IN THE  
 CONNECTION PLATES SHALL BE 24 mm DIAMETER.

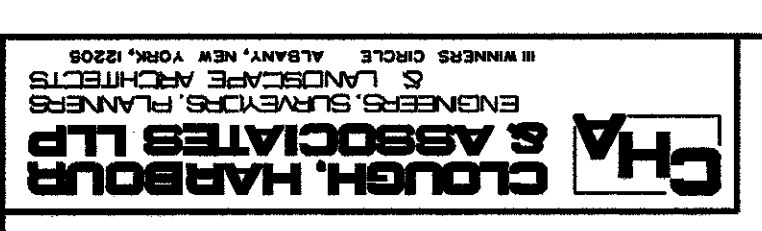