


STATE OF VERMONT AGENCY OF TRANSPORTATION	
Bridge No. BR500	Log Sta. 14+900
Town of BENNINGTON	
Highway No. VT. RTE. 9	
VT. RTE. 9 OVER AIRPORT BROOK EAST	
SPlice DETAILS	
Designed By D. VIEN	Drawn By B. WEATHERBY
Checked By P. PERKINS	Date M. OLSTAD
Project No. BENNINGTON-HOOSICK	Bridge Design Supervisor
L.C. Info. D.P.J. OMEGA	
Bridge Sheet No. BR515	
Sheet 245 OF 473	

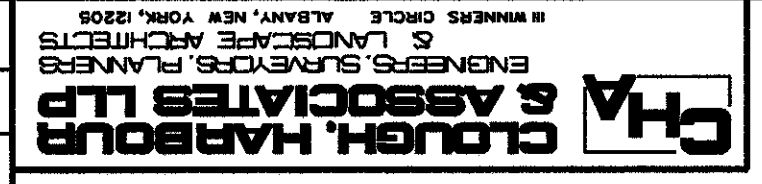

- FIELD SPICE NOTES:**
- FOR LOCATION OF GIRDER SPICES SEE BR511.
 - ALL BOLTS SHALL BE M22 BOLTS AND SHALL CONFORM TO THE REQUIREMENTS OF AASHTO M270M16M.
 - ALL SPICE PLATES AND FILLER PLATES SHALL CONFORM TO THE REQUIREMENTS OF AASHTO M270M GR345M STEEL.
 - NUTS TO BE ON INSIDE FACE OF WEB SPACE AT FASCIA GIRDERS.
 - NUTS TO BE DOWN ON ALL FLANGE SPICES.
 - COST OF FIELD SPICES TO BE INCLUDED IN THE PRICE BID FOR ITEM 506.55.
 - BOLTED CONNECTIONS SHALL HAVE THREADS EXCLUDED FROM THE SHEAR PLANES.
 - CONTACT SURFACES OF BOLTED PARTS SHALL BE CLASS B (SLIP COEF. 0.50).

GIRDER SPICE DETAILS

