

EQUALITY :
B 1+000.000 =
NB STA 8+688.832

BM # 146
 SPIKE IN ROOT 0.36 m CHERRY
 NAVD EL. 260.857

BM # 147
 SPIKE IN ROOT 0.19 m BIRCH
 NAVD EL. 251.713

BM # 145
 SPIKE IN ROOT 0.40 m PINE
 NAVD EL. 253.102

ARCHAEOLOGICALLY SENSITIVE AREA
 NO GROUND DISTURBANCE


STA B 1+365.300
LIMIT OF WORK - CONTRACT #3

BM # 144
 SPIKE IN ROOT 0.42 m PINE
 NAVD EL. 244.619

STA B 1+582.000
LIMIT OF WORK - CONTRACT #3

**CONSTRUCTION OF CULVERT
 AND CB UNDER CONTRACT #4**

AS-BUILT NOTE: REFERENCE CHANGE OF DESIGN #2 FOR REVISED BORROW PLAN RMT 2/3/06

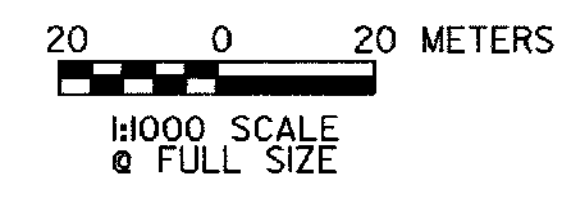

PROJECT NAME:	BENNINGTON - HOOSICK	
PROJECT NUMBER:	DPI0146 (I) C/3	
FILE NAME:	borrow spl.ptf	PLOT DATE: 10/10/2001
PROJECT LEADER:	GAS	DRAWN BY: BJM
DESIGNED BY:	BJM	CHECKED BY: GAS
SITE PLAN SP-1		SHEET 297 OF 473