


SNOW FENCE FOR PROTECTION			
STATION	STATION	LOCATION	QUANTITY
MAINLINE			
B 1+362	B 1+470	LT.	138 m
B 1+362	B 1+470	RT.	152 m

HAYBALES FOR EROSION			
STATION	STATION	LOCATION	QUANTITY
MAINLINE			
B 1+372		LT.	14 EA
B 1+382	B 1+400	LT.	48 EA
B 1+392	B 1+470	LT.	100 EA
B 1+372	B 1+434	RT.	100 EA
B 1+382	B 1+470	RT.	103 EA
B 1+392	B 1+470	RT.	88 EA

2A
BENNINGTON COUNTY INDUSTRIAL CORP. (CHRIS HUNSINGER)

3
ALAN HOOD

4A
HENRY LYONS

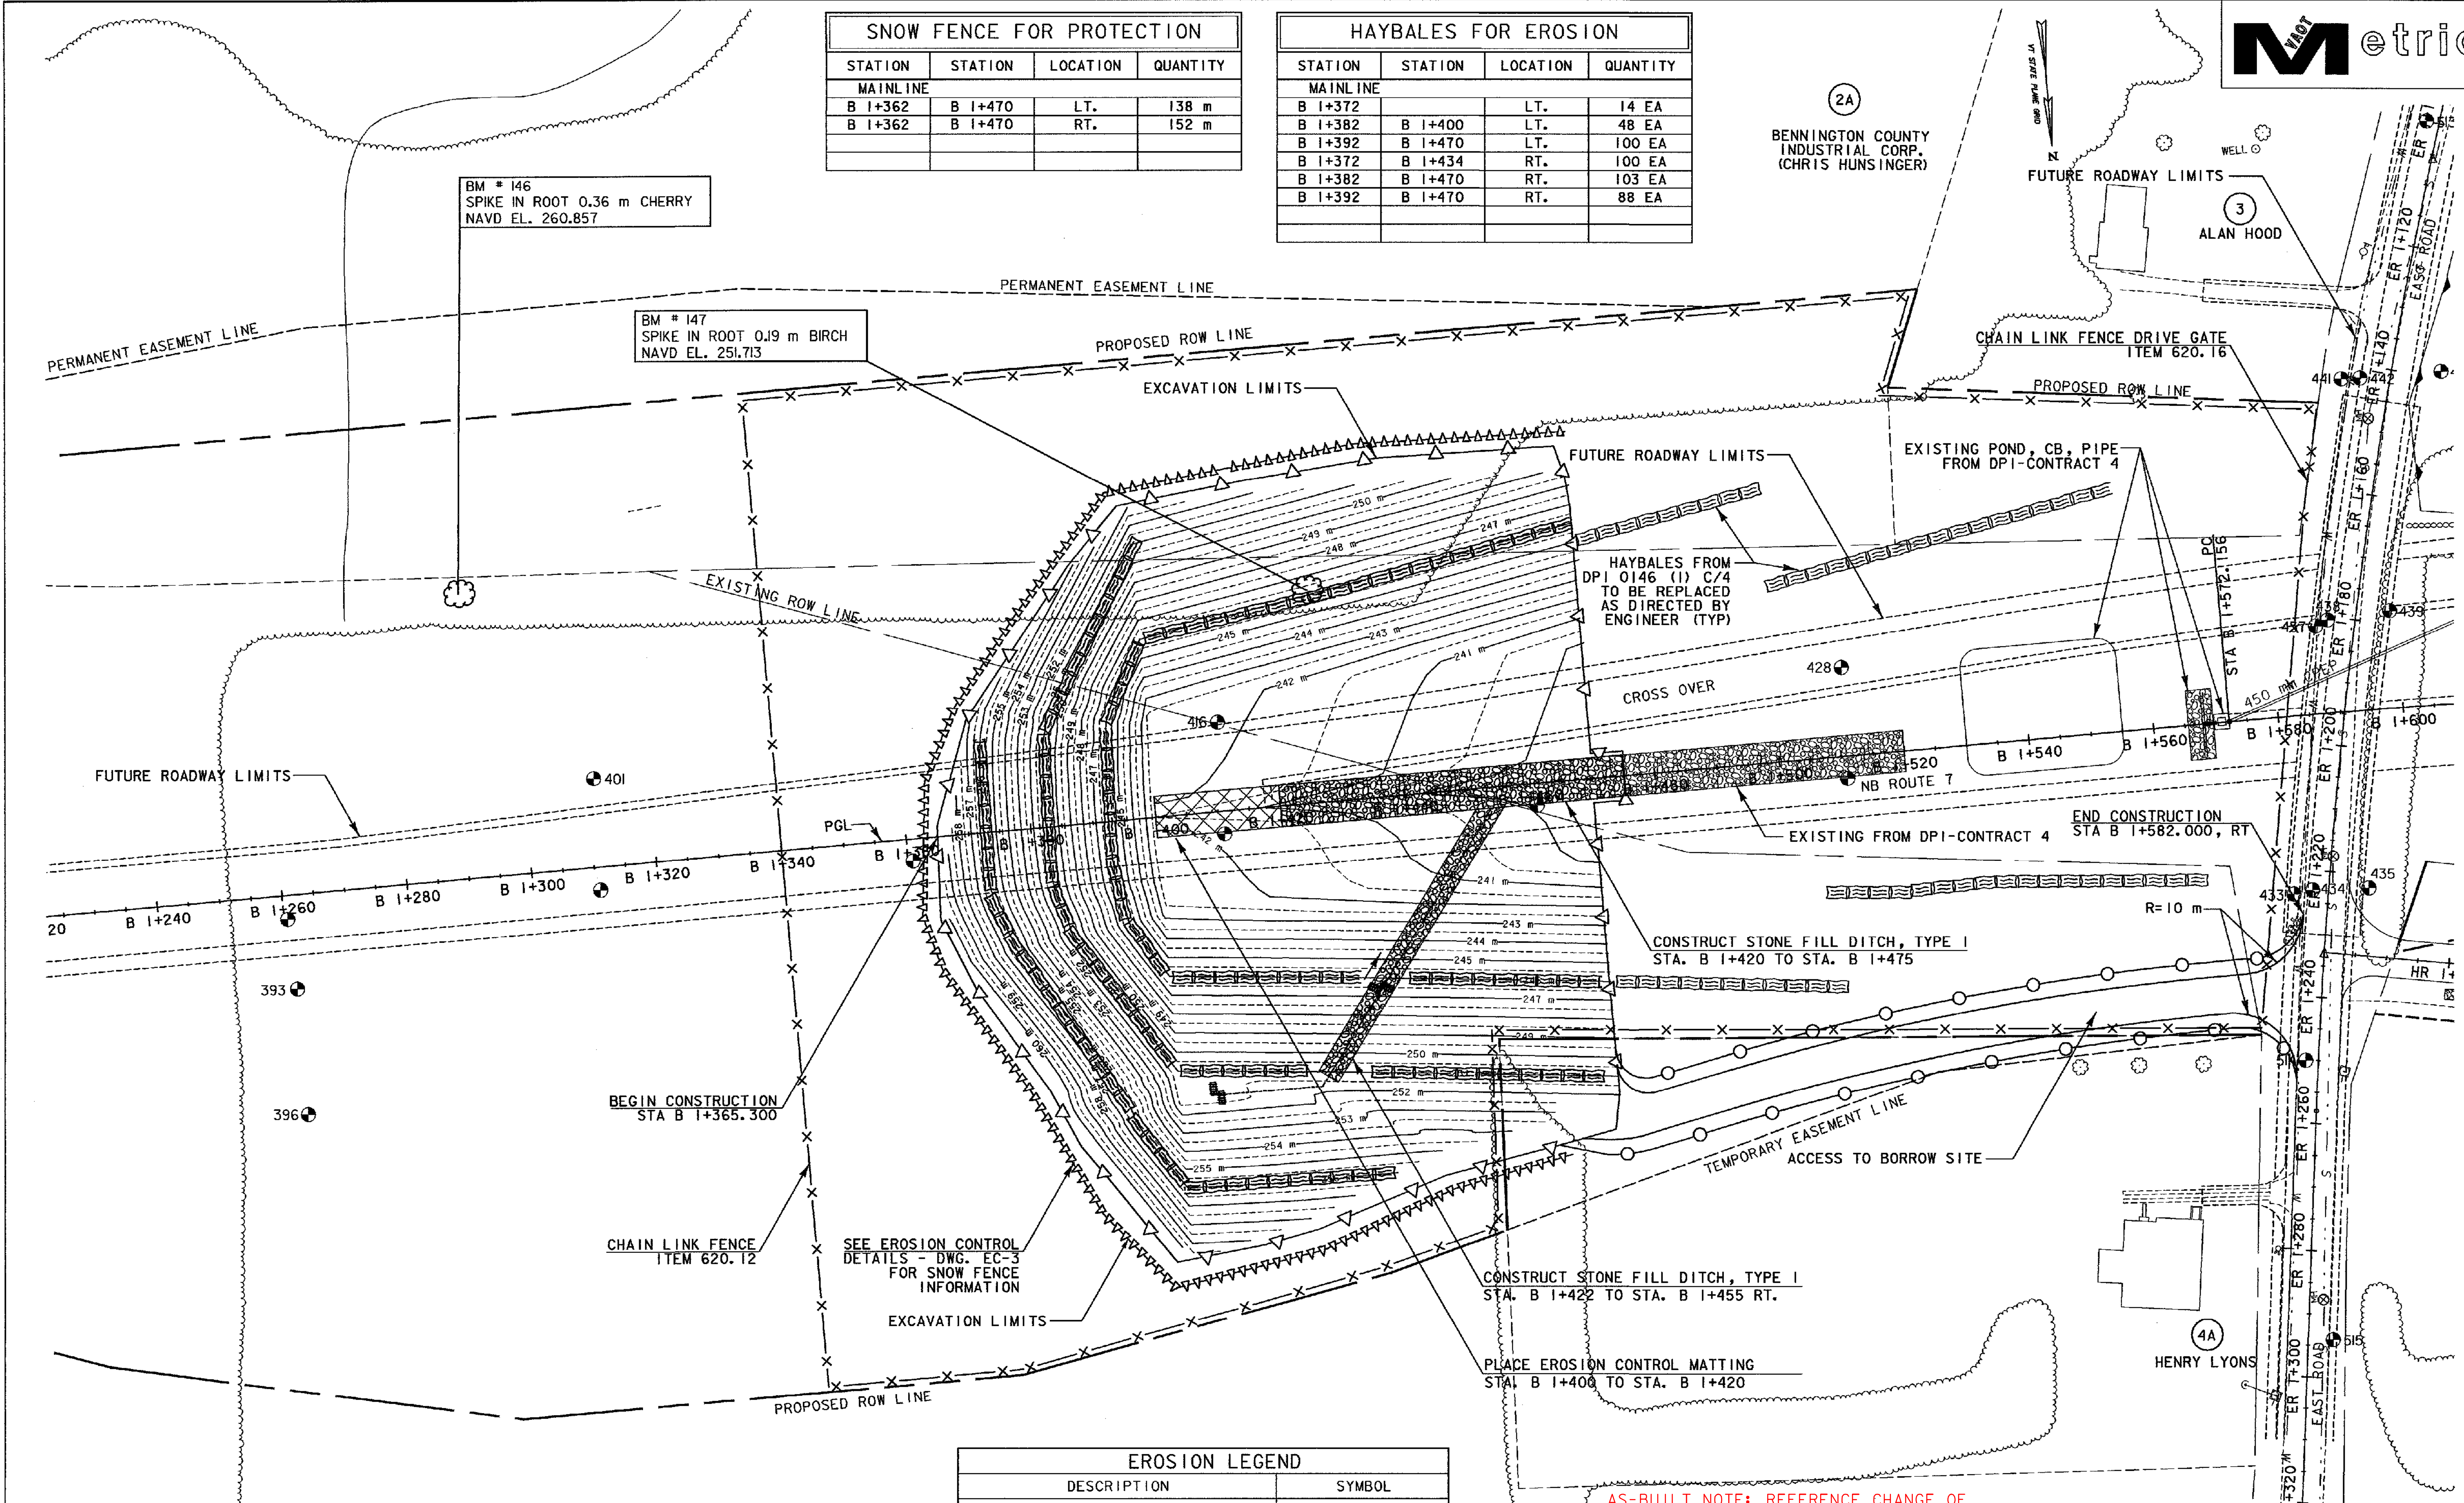

BM # 146
SPIKE IN ROOT 0.36 m CHERRY
NAVD EL. 260.857

BM # 147
SPIKE IN ROOT 0.19 m BIRCH
NAVD EL. 251.713


BEGIN CONSTRUCTION
STA B 1+365.300

CHAIN LINK FENCE
ITEM 620.12

SEE EROSION CONTROL
DETAILS - DWG. EC-3
FOR SNOW FENCE
INFORMATION

AS-BUILT NOTE: REFERENCE CHANGE OF DESIGN #2 FOR REVISED BORROW PLAN RMT 2/3/06 ALL DIMENSIONS IN MILLIMETERS EXCEPT WHERE OTHERWISE INDICATED.

EROSION LEGEND	
DESCRIPTION	SYMBOL
HAY/STRAWBALE CHECKDAM	
HAY/STRAWBALE (HAYBALE DIKE)	
SILT FENCE	
SILT FENCE FOR CULVERT INLET PROTECTION	
SNOW FENCE (MOD)	

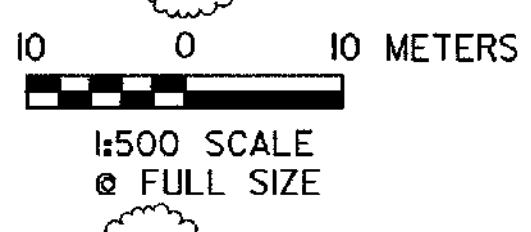

1
MOUNT ANTHONY UNION
HIGH SCHOOL, DIST. #14



PROJECT NAME: BENNINGTON - HOOSICK
PROJECT NUMBER: DPI 0146 (I) C/3
FILE NAME: borrow C3 2.pif
PROJECT LEADER: GAS
DESIGNED BY: BJM
CHECKED BY: GAS
PLOT DATE: 10/10/2001
DRAWN BY: MBL
CHECKED BY: GAS
SHEET 298 OF 473
BORROW AREA PL-1