


ABBREVIATION	DESCRIPTION
CL ST	CLAYEY SILT
FM	FOREST MAT
FSN ST	FINE SAND & SILT
GT	GLACIAL TILL
NLTD	NO LEDGE TO DEPTH
SN	SAND
SN ST	SANDY SILT
ST	SILT
TS	TOP SOIL
WGT	WEATHERED GLACIAL TILL
SSR	SPLIT SPOON REFUSAL

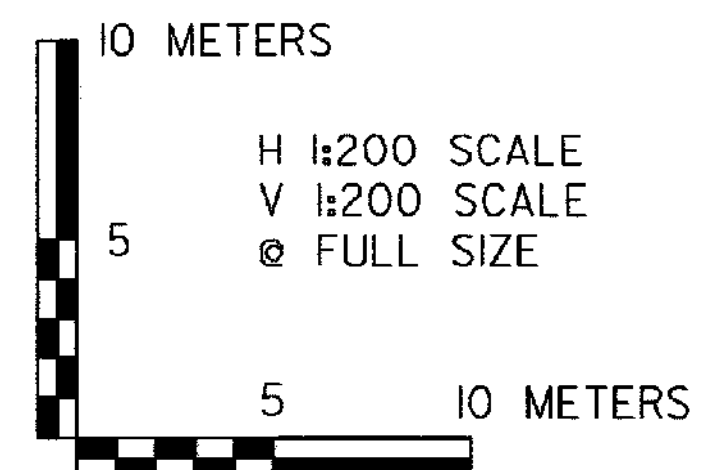

AS-BUILT NOTE: SEE NOTE ON SHEET 299. RMT 2/3/06
ALL DIMENSIONS IN MILLIMETERS EXCEPT WHERE OTHERWISE INDICATED.

PROJECT NAME: BENNINGTON - HOOSICK
PROJECT NUMBER: DPI0146 (I) C/3

FILE NAME: c3 xs.dgn
PROJECT LEADER: GAS
DESIGNED BY: BJM

PLOT DATE: 10/10/2001
DRAWN BY: MBL
CHECKED BY:

BORROW AREA CROSS SECTIONS
SHEET 300 OF 473