


ABBREVIATION	DESCRIPTION
CL ST	CLAYEY SILT
FM	FOREST MAT
FSN ST	FINE SAND & SILT
GT	GLACIAL TILL
NLTD	NO LEDGE TO DEPTH
SN	SAND
SN ST	SANDY SILT
ST	SILT
TS	TOP SOIL
WGT	WEATHERED GLACIAL TILL
SSR	SPLIT SPOON REFUSAL

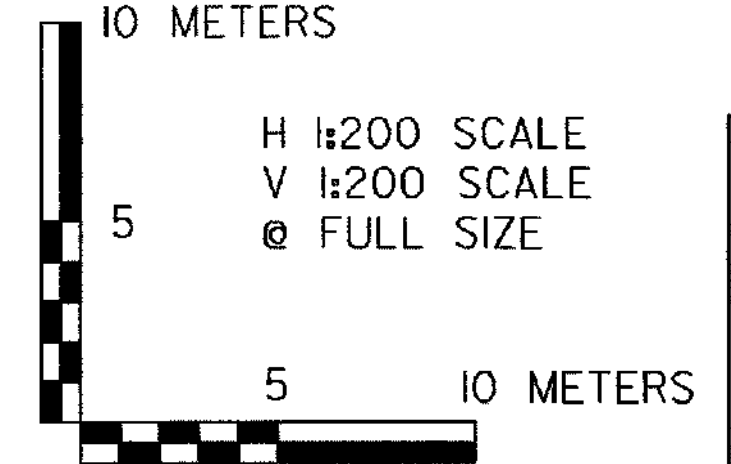

AS-BUILT NOTE: SEE NOTE ON SHEET 299 RMT 2/3/06
ALL DIMENSIONS IN MILLIMETERS EXCEPT WHERE OTHERWISE INDICATED.

PROJECT NAME:	BENNINGTON - HOOSICK	PLOT DATE:	10/10/2001
PROJECT NUMBER:	DPI0146 (1) C/3	DRAWN BY:	MBL
FILE NAME:	c3 xs.dgn	CHECKED BY:	BJM
DESIGNED BY:	BJM	BORROW AREA CROSS SECTIONS	SHEET 301 OF 473