



$C = 126.7916m^2$   
 $F = 8.547m^2$   
 $R = 95.5957m^2$   
**AESTHETIC FILL = 58.716m<sup>2</sup>**


Checked by: RRM  
 JKW VHS  
 RMT 2/24/05  
 JRM 2/29/05

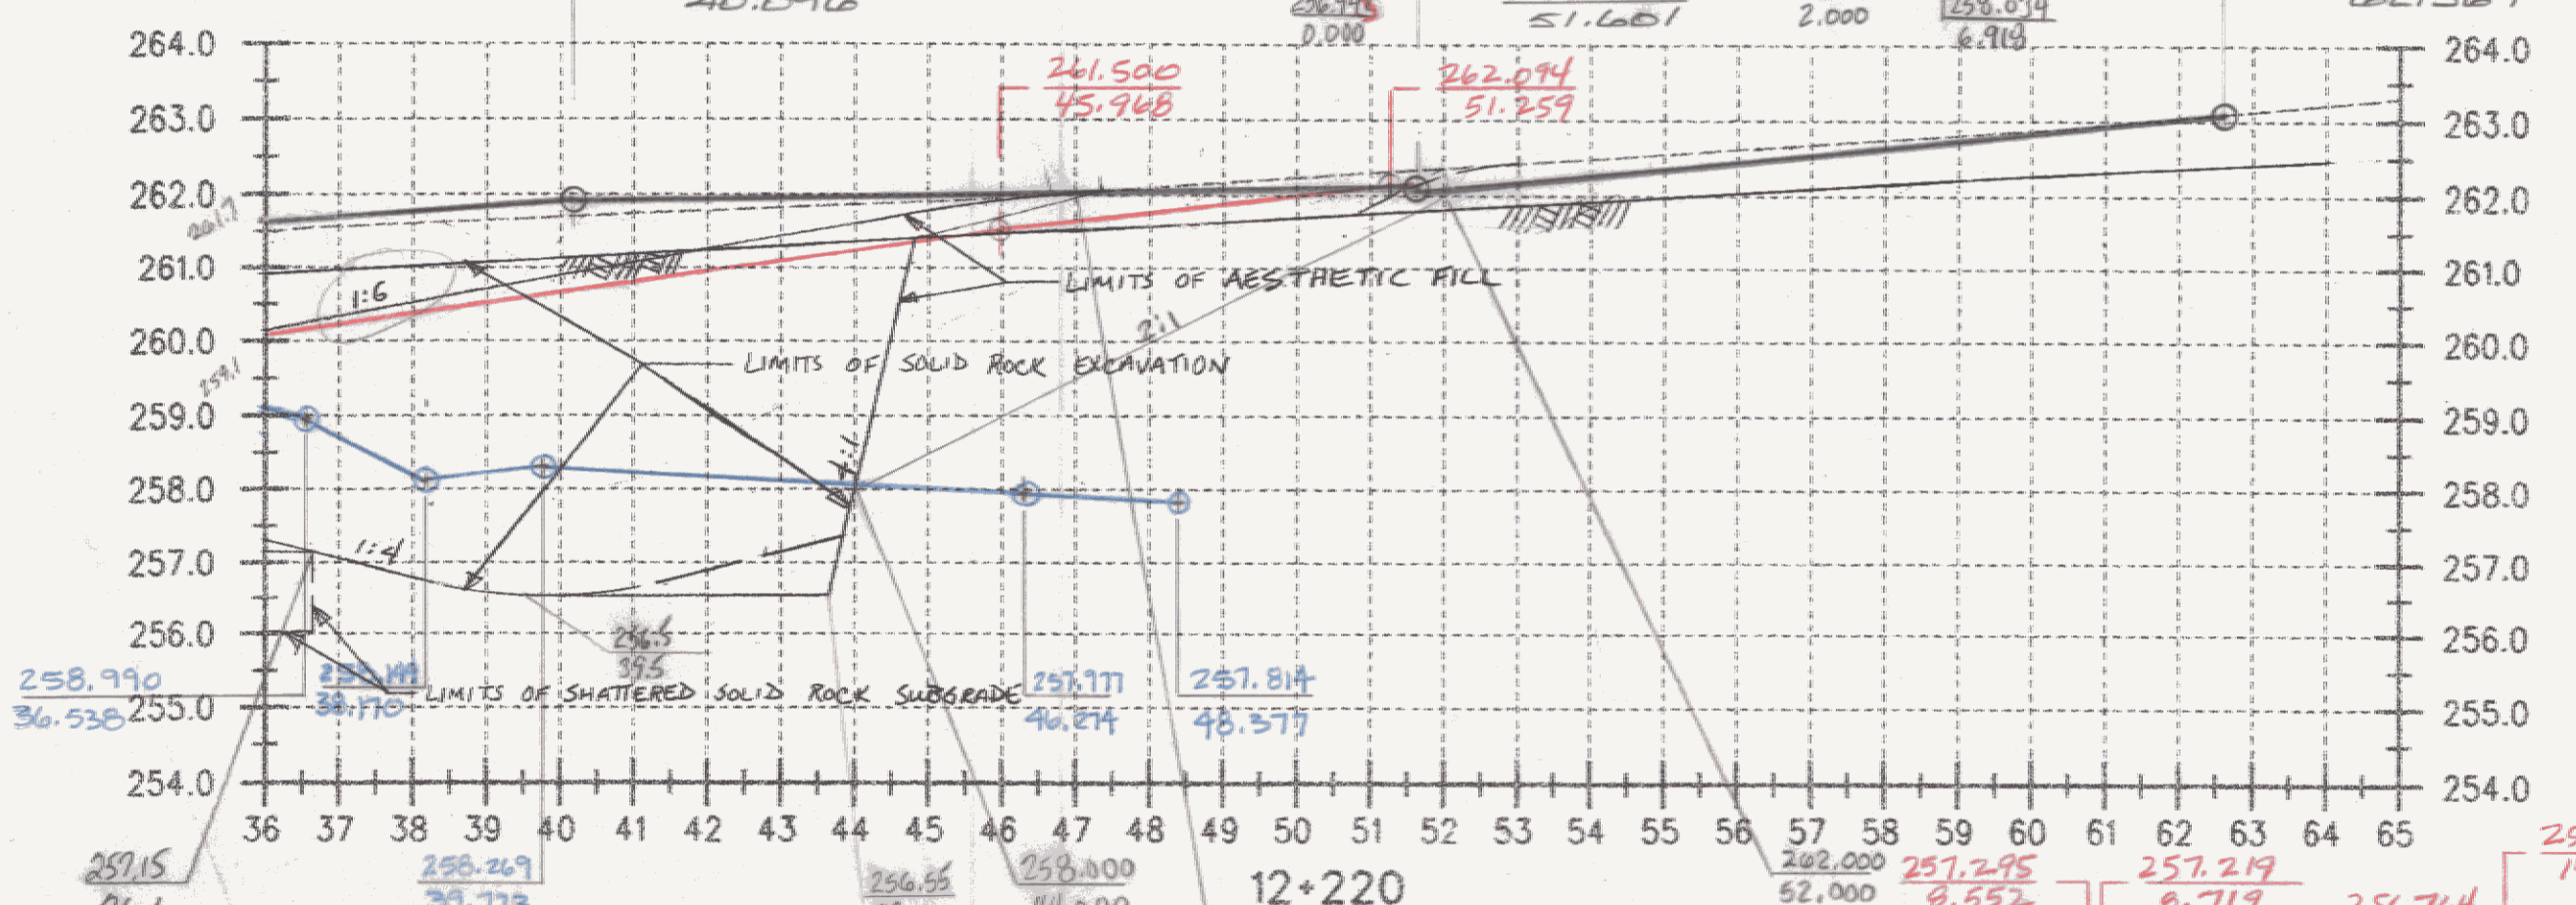

17.6

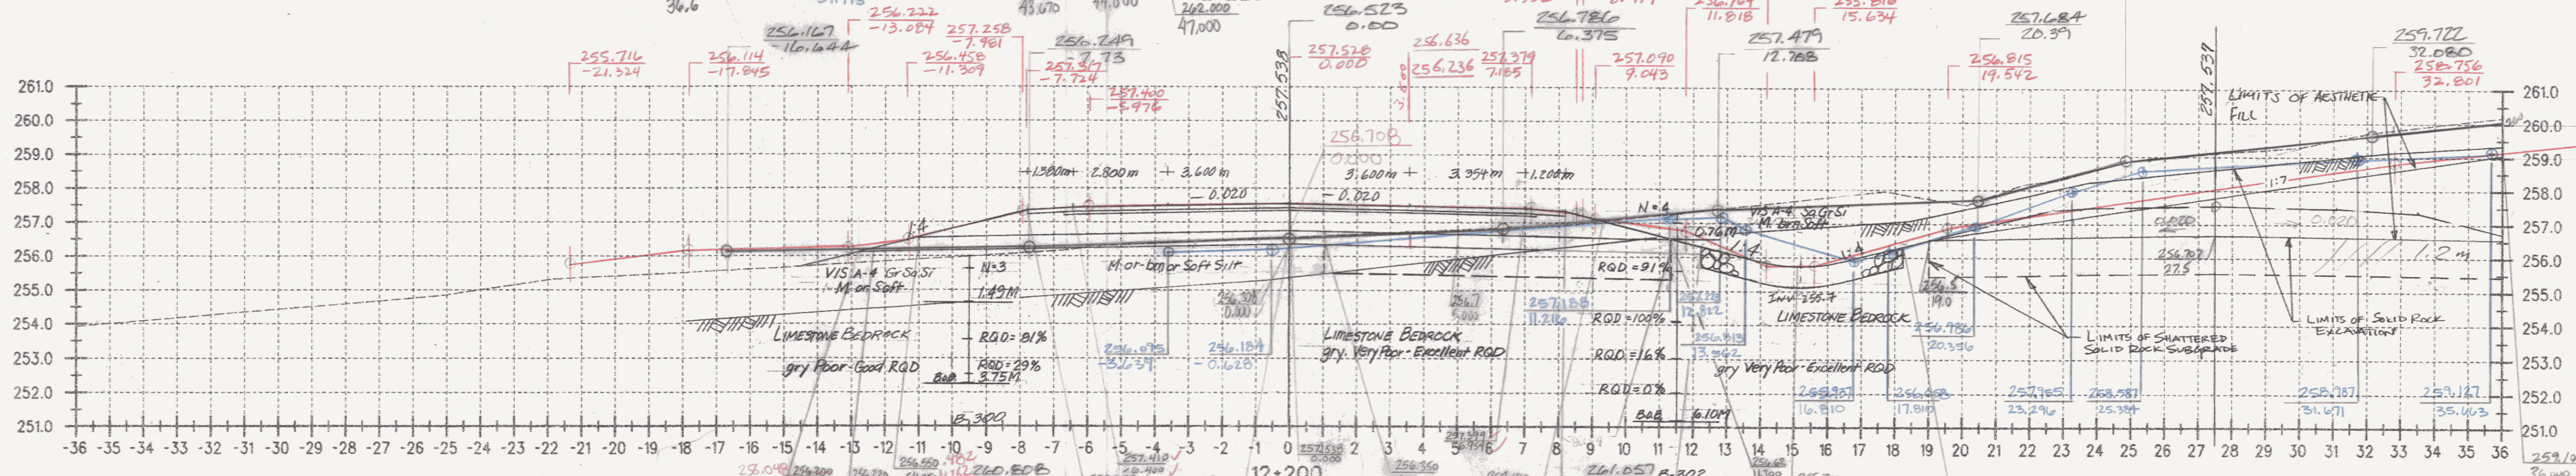

17.7  
10.3

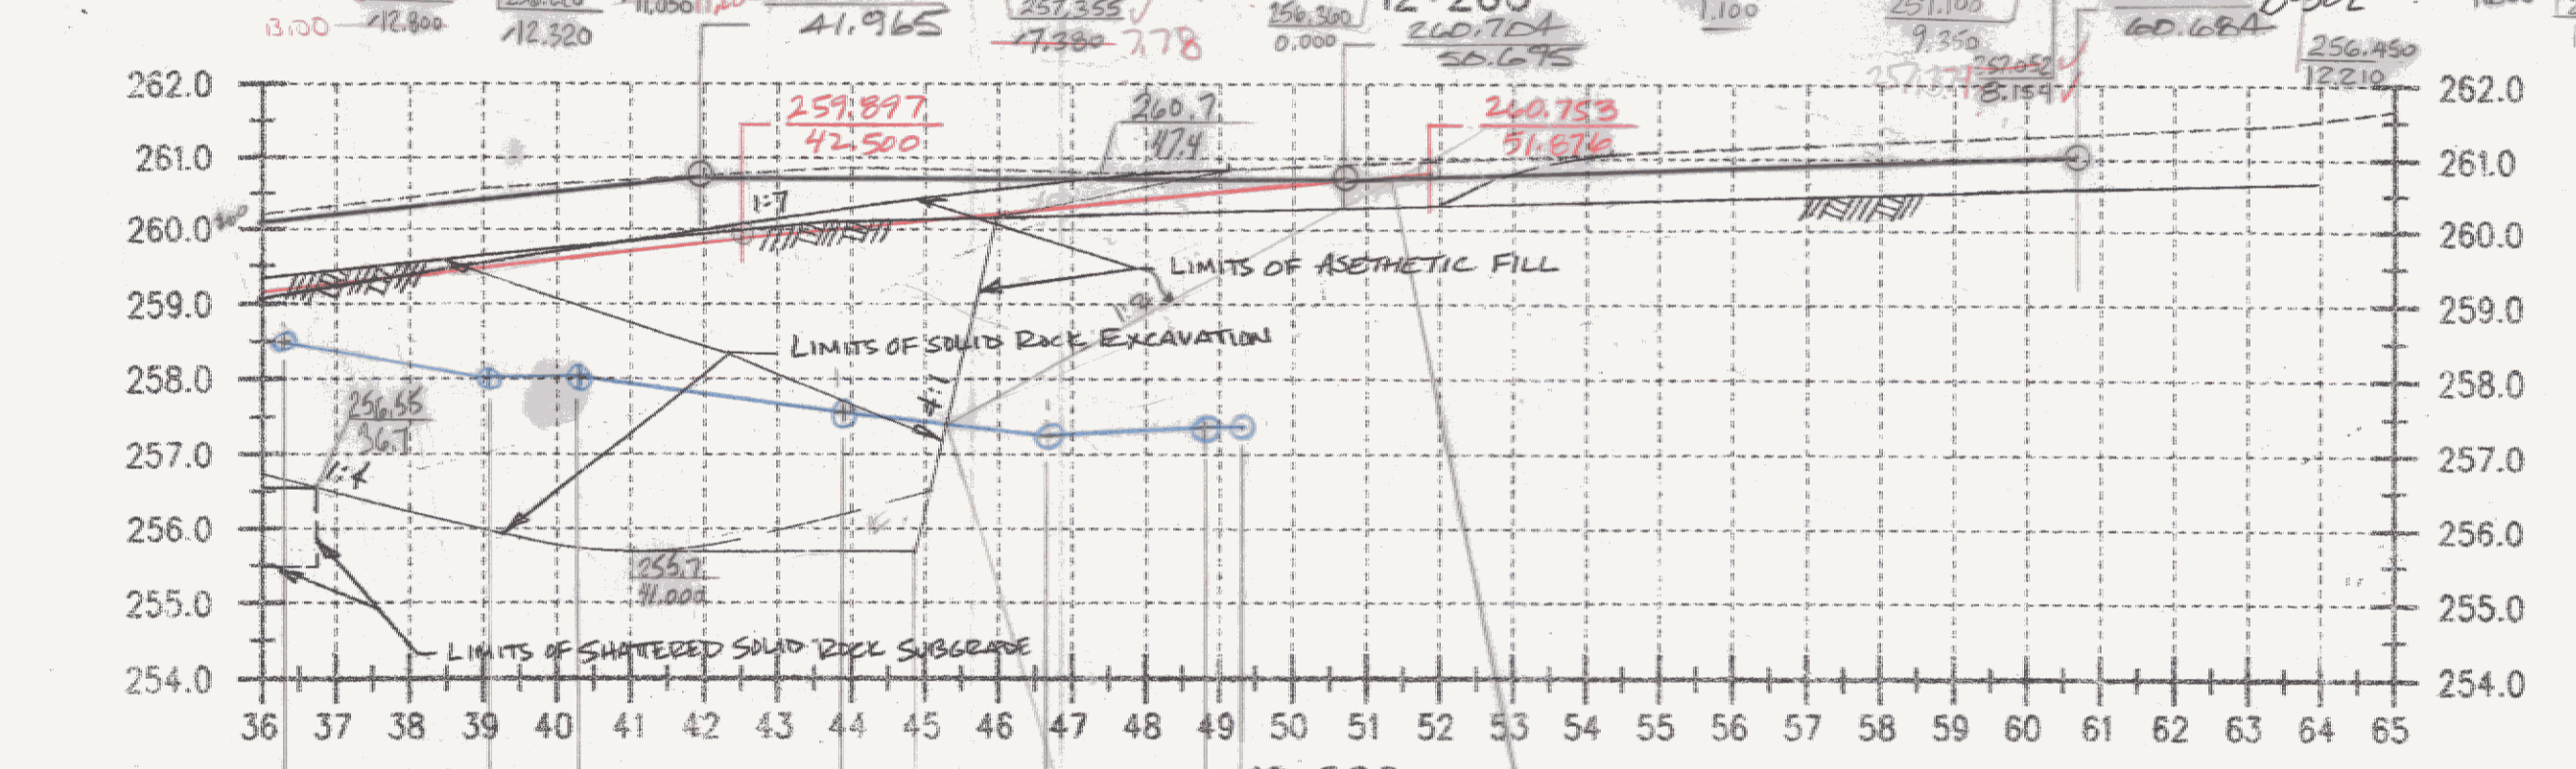


$54.59m^2 = 1.72 + 18.54 + 34.28$   
 $C = 108$   
 $F = 8$   
 $R = 75$   
**63.34m<sup>2</sup> AESTHETIC FILL = 59**

Checked by: RRM  
 JKW VHS  
 RMT 2/24/05  
 JRM 2/29/05

DATUM

|            |               |
|------------|---------------|
| VERTICAL   | NAVD 88       |
| HORIZONTAL | NAD 83 (1992) |

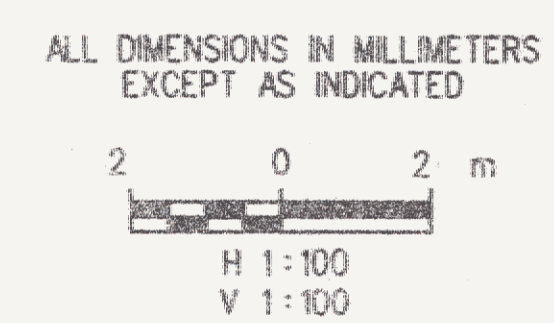

|                 |                      |              |            |
|-----------------|----------------------|--------------|------------|
| SURVEYED BY     | C.H.A. & V.S.E.      | DATE         |            |
| DRAWN BY        | J.S.L.               | DATE         |            |
| SQUAD LEADER    | T.P.K.               |              |            |
| DESIGN FILE NO. | n/o                  |              |            |
| FORM FILE       |                      | DATE PLOTTED |            |
| PROJ. NAME      | BENNINGTON - HOOSICK |              |            |
| PROJ. NO.       | P.I.N. 1306.60.201   |              |            |
| SHEET           | 311                  | OF           | 473 SHEETS |