


$C = 134 \text{ } 37.60 \text{ m}^2$   
 $F = 17 \text{ } 17.39 \text{ m}^2$   
 $R = 96 \text{ } 80.33 \text{ m}^2$   
**AESTHETIC FILL = 65.65.63 m<sup>2</sup>**

$C = 128 \text{ } 24.71 \text{ m}^2$   
 $F = 21 \text{ } 14.42 \text{ m}^2$   
 $R = 93 \text{ } 91.05 \text{ m}^2$   
**AESTHETIC FILL = 65.65.08 m<sup>2</sup>**

DATUM	
VERTICAL	NAVD 88
HORIZONTAL	NAD 83 (1992)

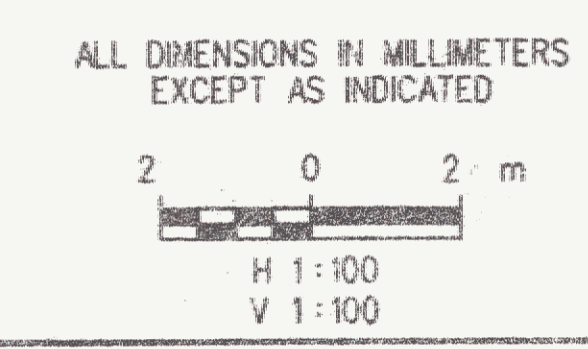

SURVEYED BY	C.H.A. & V.S.E. DATE
DRAWN BY	J.S.L. DATE
SQUAD LEADER	T.P.K.
DESIGN FILE NO.	n/a
IPARM FILE	DATE PLOTTED
PROJ. NAME	BENNINGTON - HOOSICK D.P.I. 0146(1) C/3
PROJ. NO.	P.I.N. 1306.60.201
SHEET	315 OF 473 SHEETS