


$C = 107 \quad 39.48m^2$
 $F = 20 \quad 18.22m^2$
 $R = 76 \quad 72.08m^2$
AESTHETIC FILL = 31 32.49m²

$C = 117 \quad 36.51m^2$
 $F = 48 \quad 15.75m^2$
 $R = 84 \quad 81.65m^2$
AESTHETIC FILL = 60 60.42m²

DATUM

VERTICAL	NAVD 88
HORIZONTAL	NAD 83 (1992)

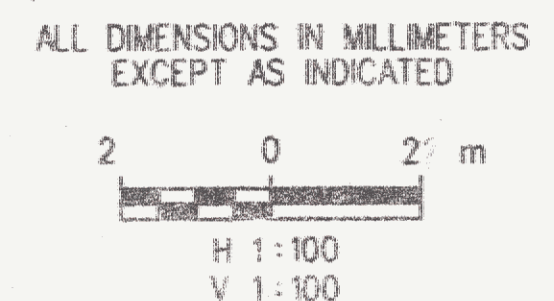

SURVEYED BY	C.H.A. & V.S.E.	DATE	
DRAWN BY	J.S.L.	DATE	
SQUAD LEADER	T.P.K.		
DESIGN FILE NO.	n/o		
IPARM FILE		DATE PLOTTED	
PROJ. NAME	BENNINGTON - HOOSICK		
	D.P.I. 0146(1) C/3		
PROJ. NO.	P.I.N. 1306.60.201		
SHEET	316 OF 473 SHEETS		