
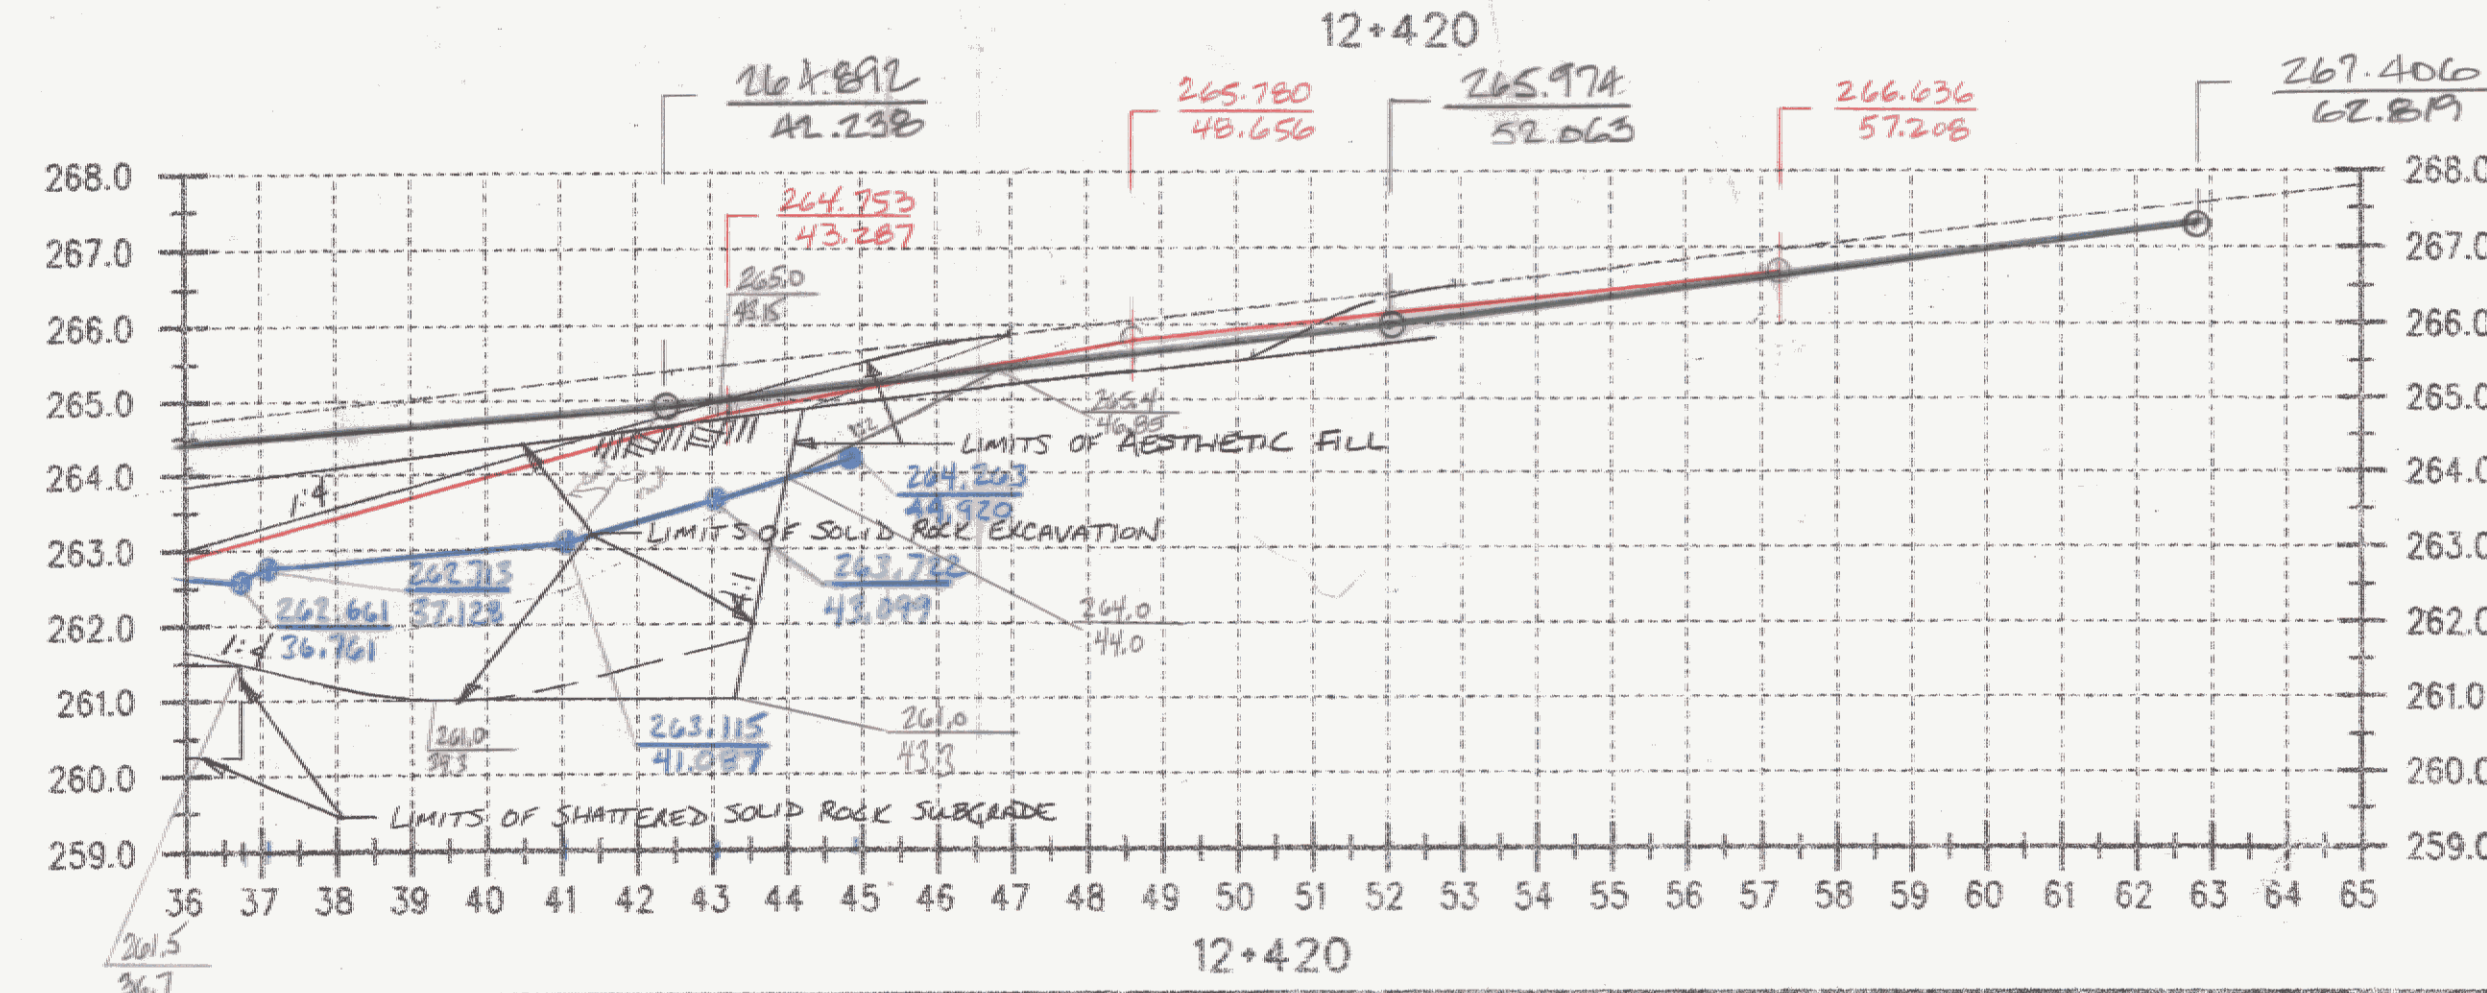


$C = 92$
 $F = 18$
 $R = 64 \text{ m}$
 AESTHETIC FILL = 56

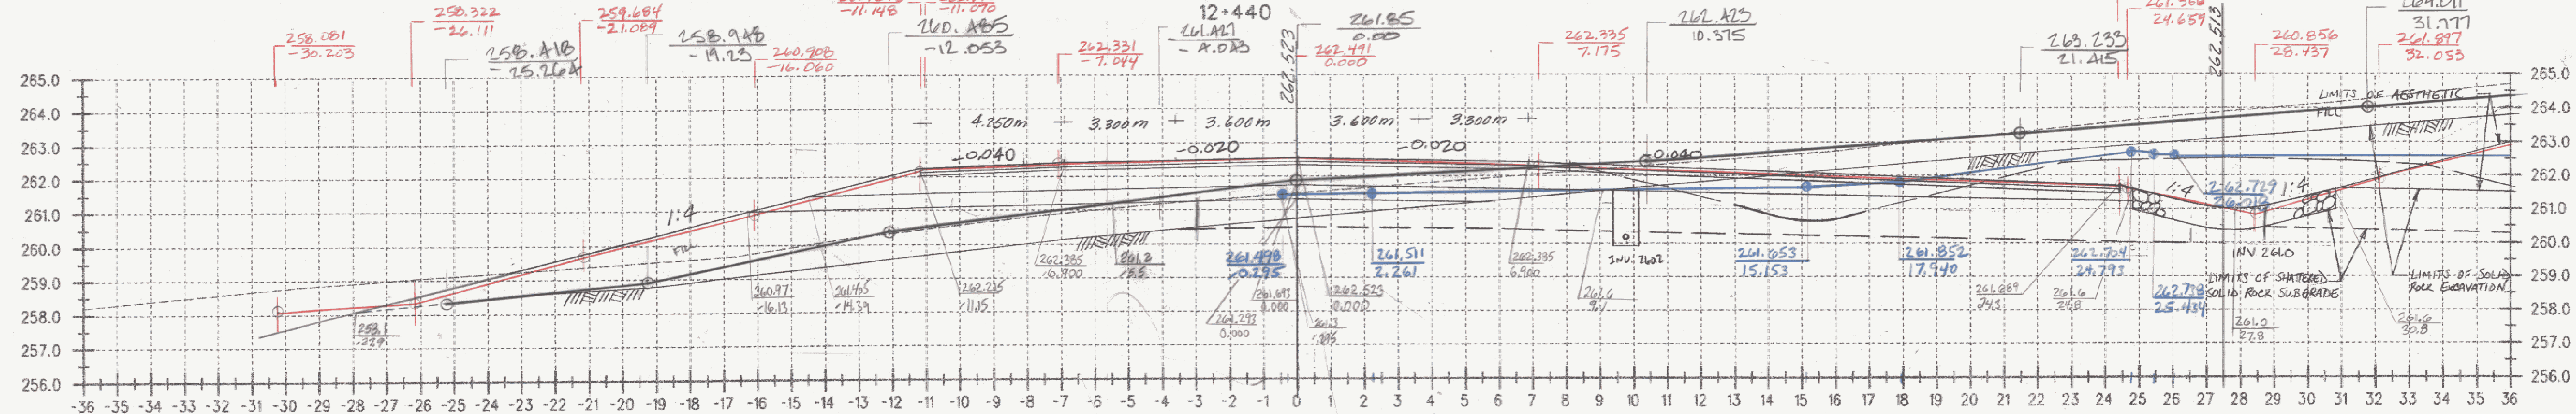

$45.21 + 4.52 \quad C = 86 \quad 49.730 \text{ m}^2$
 $F = 16 \quad 15.11 \text{ m}^2$
 $R = 84 \quad 37.59 \text{ m}^2$
 AESTHETIC FILL = 28.46 m^2

DATUM
 VERTICAL NAVD 88
 HORIZONTAL NAD 83 (1992)

ALL DIMENSIONS IN MILLIMETERS EXCEPT AS INDICATED
 2 0 2 m
 H 1:100
 V 1:100

SURVEYED BY	C.H.A. & V.S.E.	DATE	
DRAWN BY	J.S.L.	DATE	
SQUAD LEADER	T.P.K.		
DESIGN FILE NO.	n/a		
IPARM FILE		DATE PLOTTED	
PROJ. NAME	BENNINGTON - HOOSICK		
	D.P.I. 0146(1) c/3		
PROJ. NO.	P.I.N. 1306.60.201		
SHEET	317 OF 473 SHEETS		