
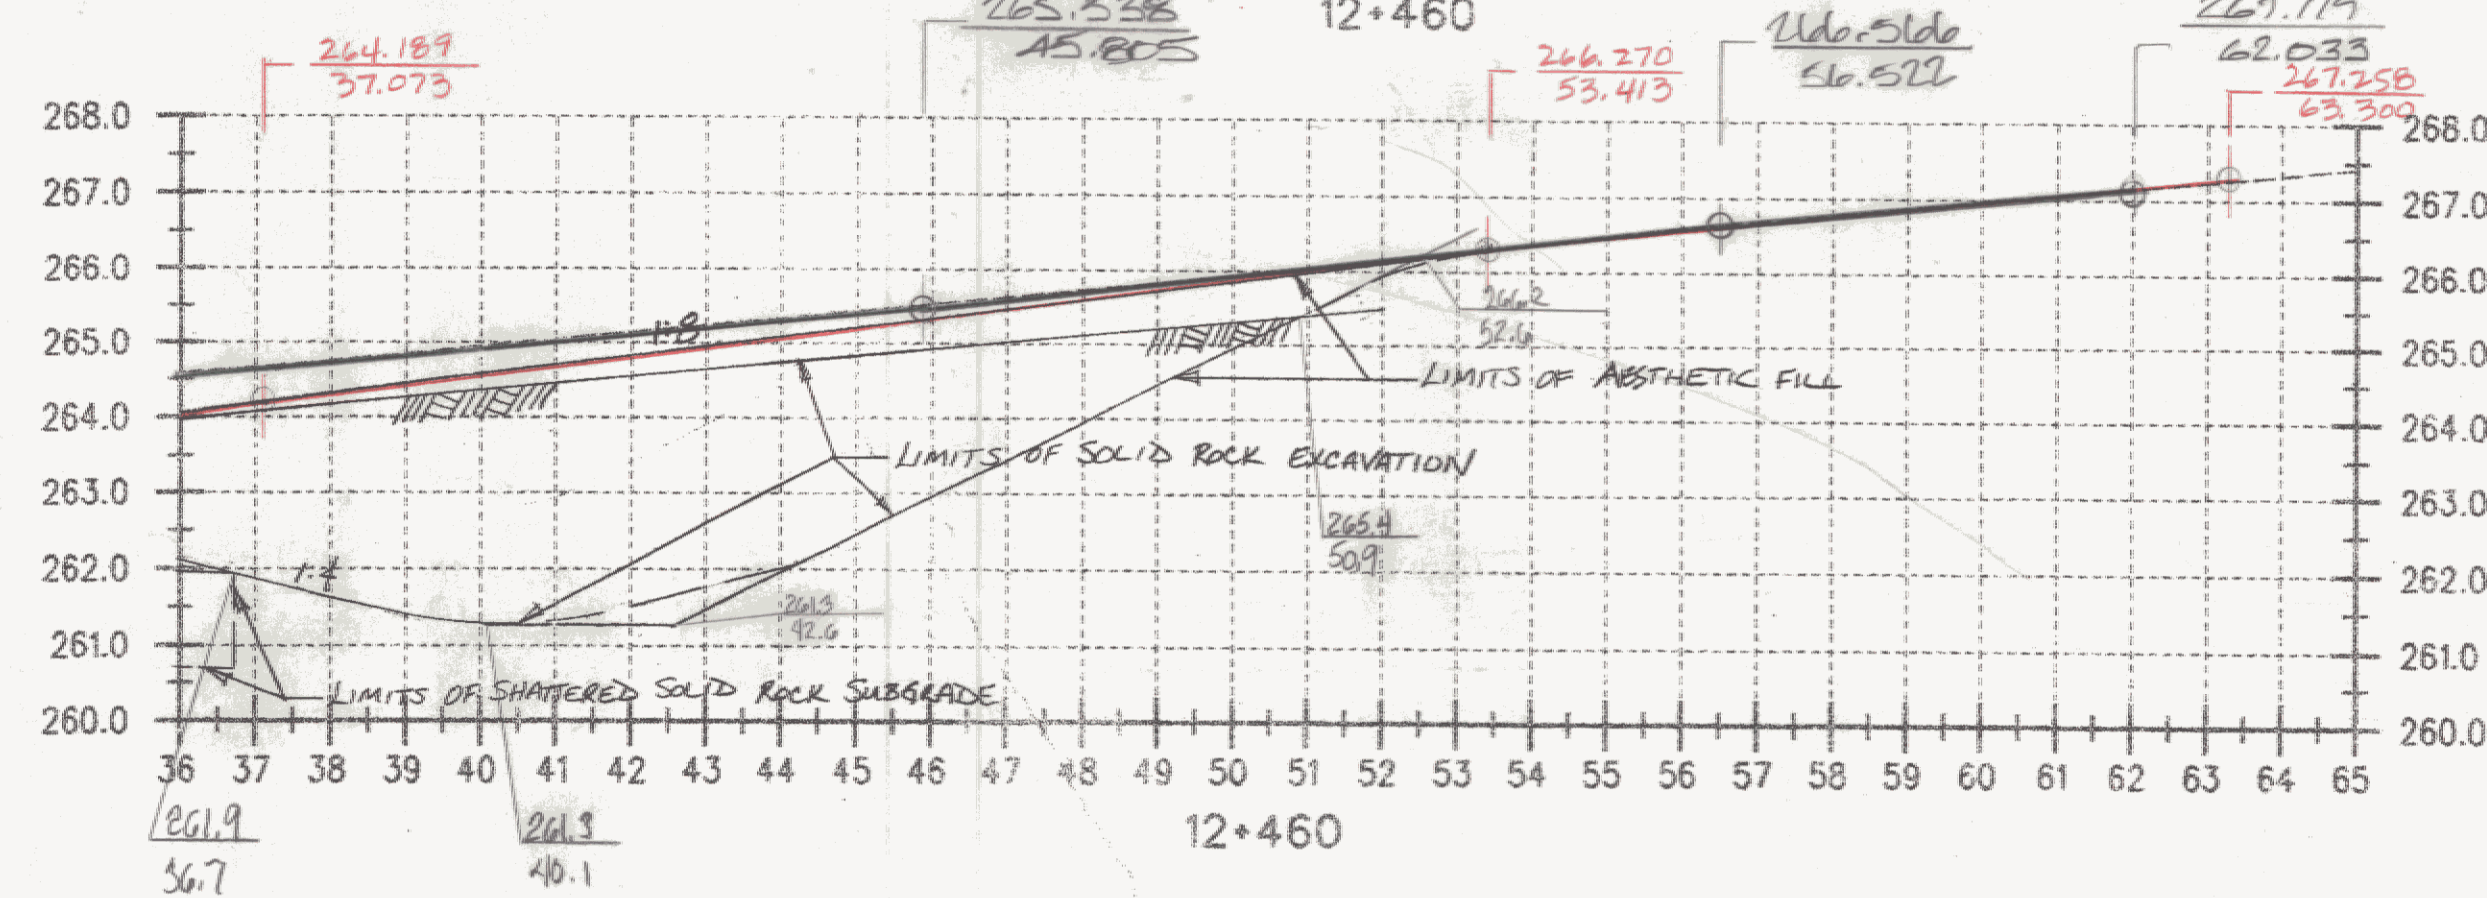


AC. TA  3/1/15  
 ROCK  3/1/15  
 FG.  3/1/15  
  
 $C = 85.87.43m^2$   
 $F = 19.11.24m^2$   
 $R = 58.0m^2$   
 AESTHETIC FILL = 50.50.3m<sup>2</sup>

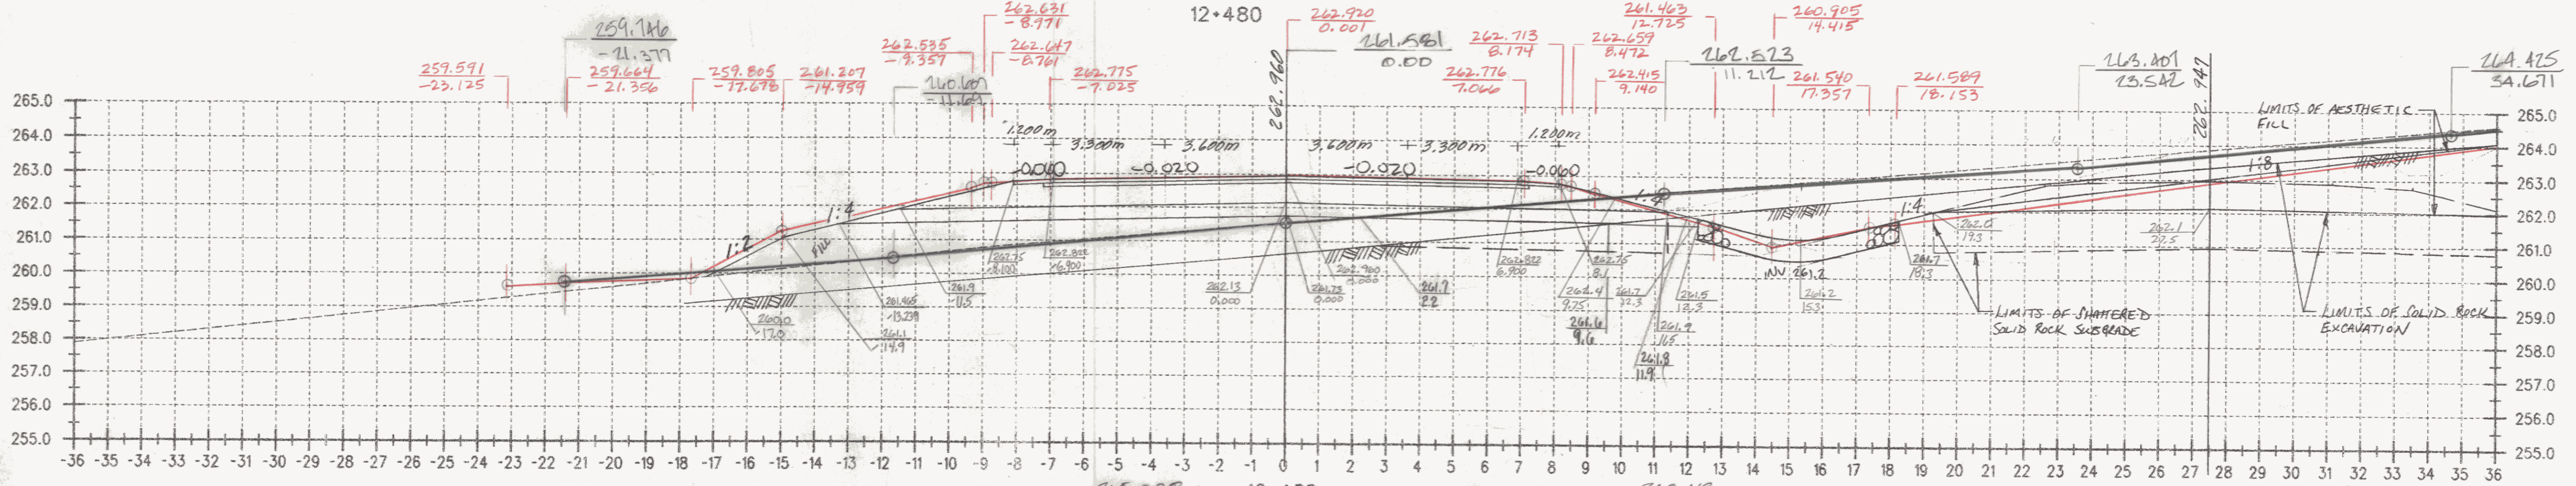

AC. TA  3/1/15  
 ROCK  3/1/15  
 FG.  3/1/15  
  
 $C = 91.86.24m^2$   
 $F = 15.10.20m^2$   
 $R = 59.0m^2$   
 AESTHETIC FILL = 54.55.13m<sup>2</sup>

DATUM

VERTICAL	NAVD 88
HORIZONTAL	NAD 83 (1992)

ALL DIMENSIONS IN MILLIMETERS EXCEPT AS INDICATED  
 2 0 2 m  
 H 1:100  
 V 1:100

SURVEYED BY	C.H.A. & V.S.E.	DATE	
DRAWN BY	J.S.L.	DATE	
SQUAD LEADER	T.P.K.		
DESIGN FILE NO.	n/o		
IPARM FILE		DATE PLOTTED	
PROJ. NAME	BENNINGTON - HOOSICK		
	D.P.I. 0146(1) c/3		
PROJ. NO.	P.J.N. 1306.60.201		
SHEET	318 OF 473 SHEETS		