

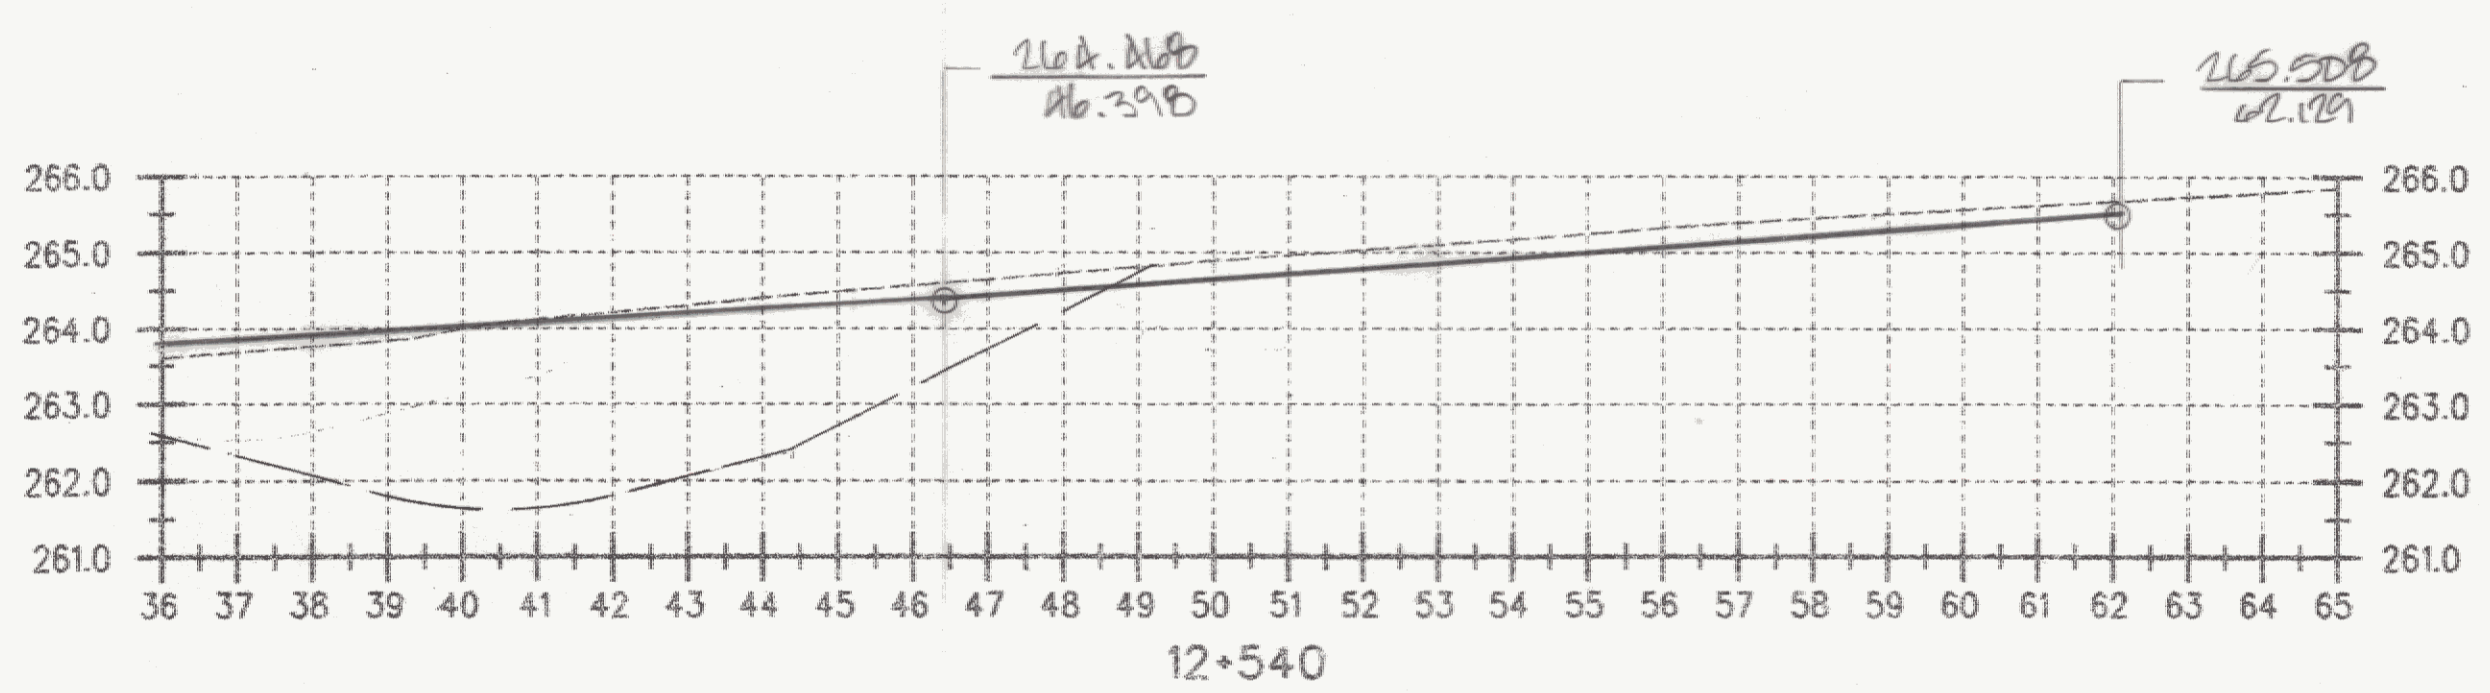
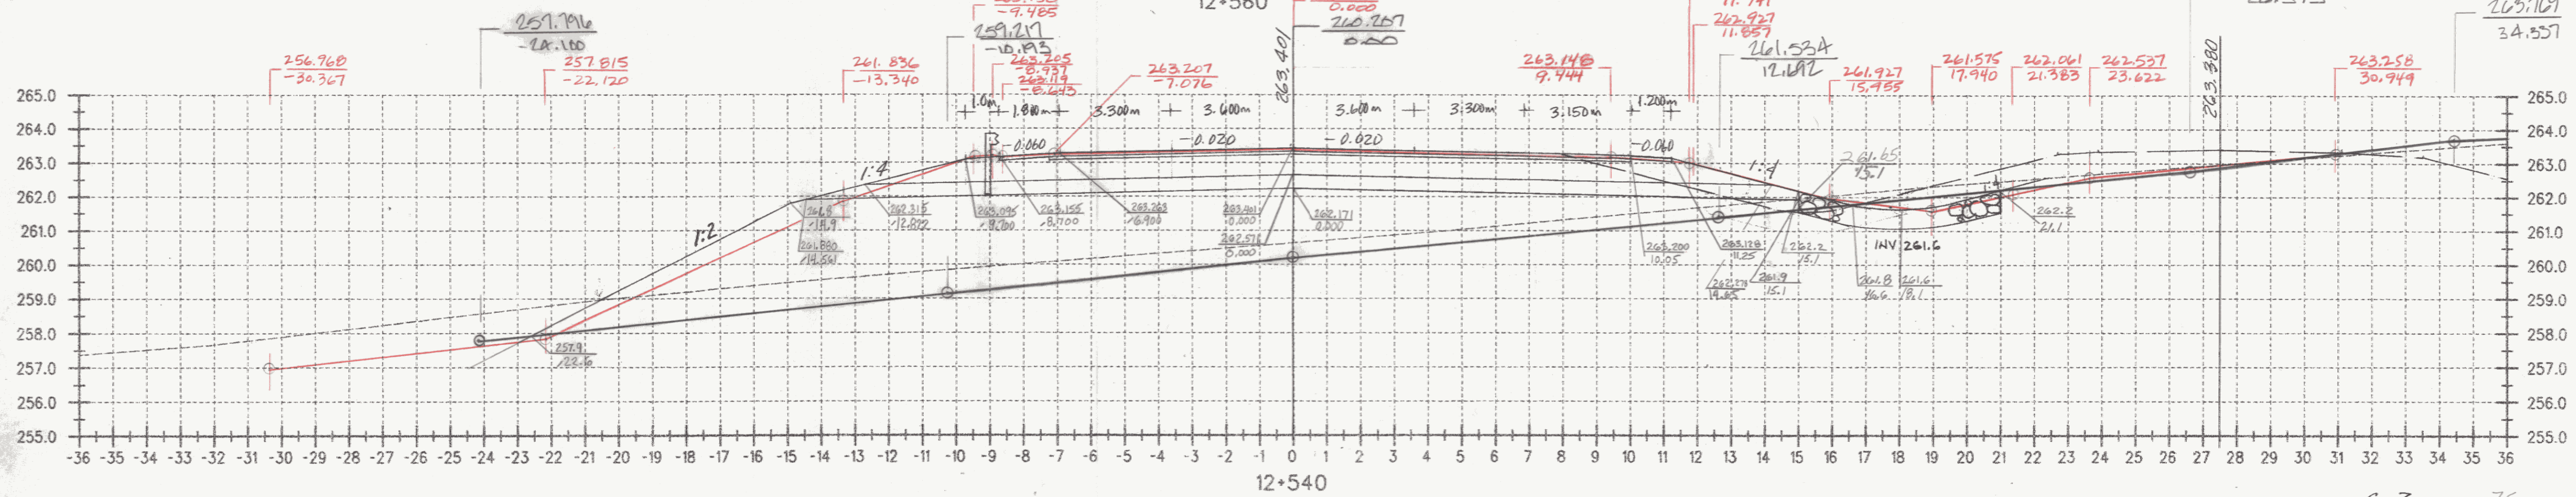


4.81 C=7
87.03 F=86
R=0

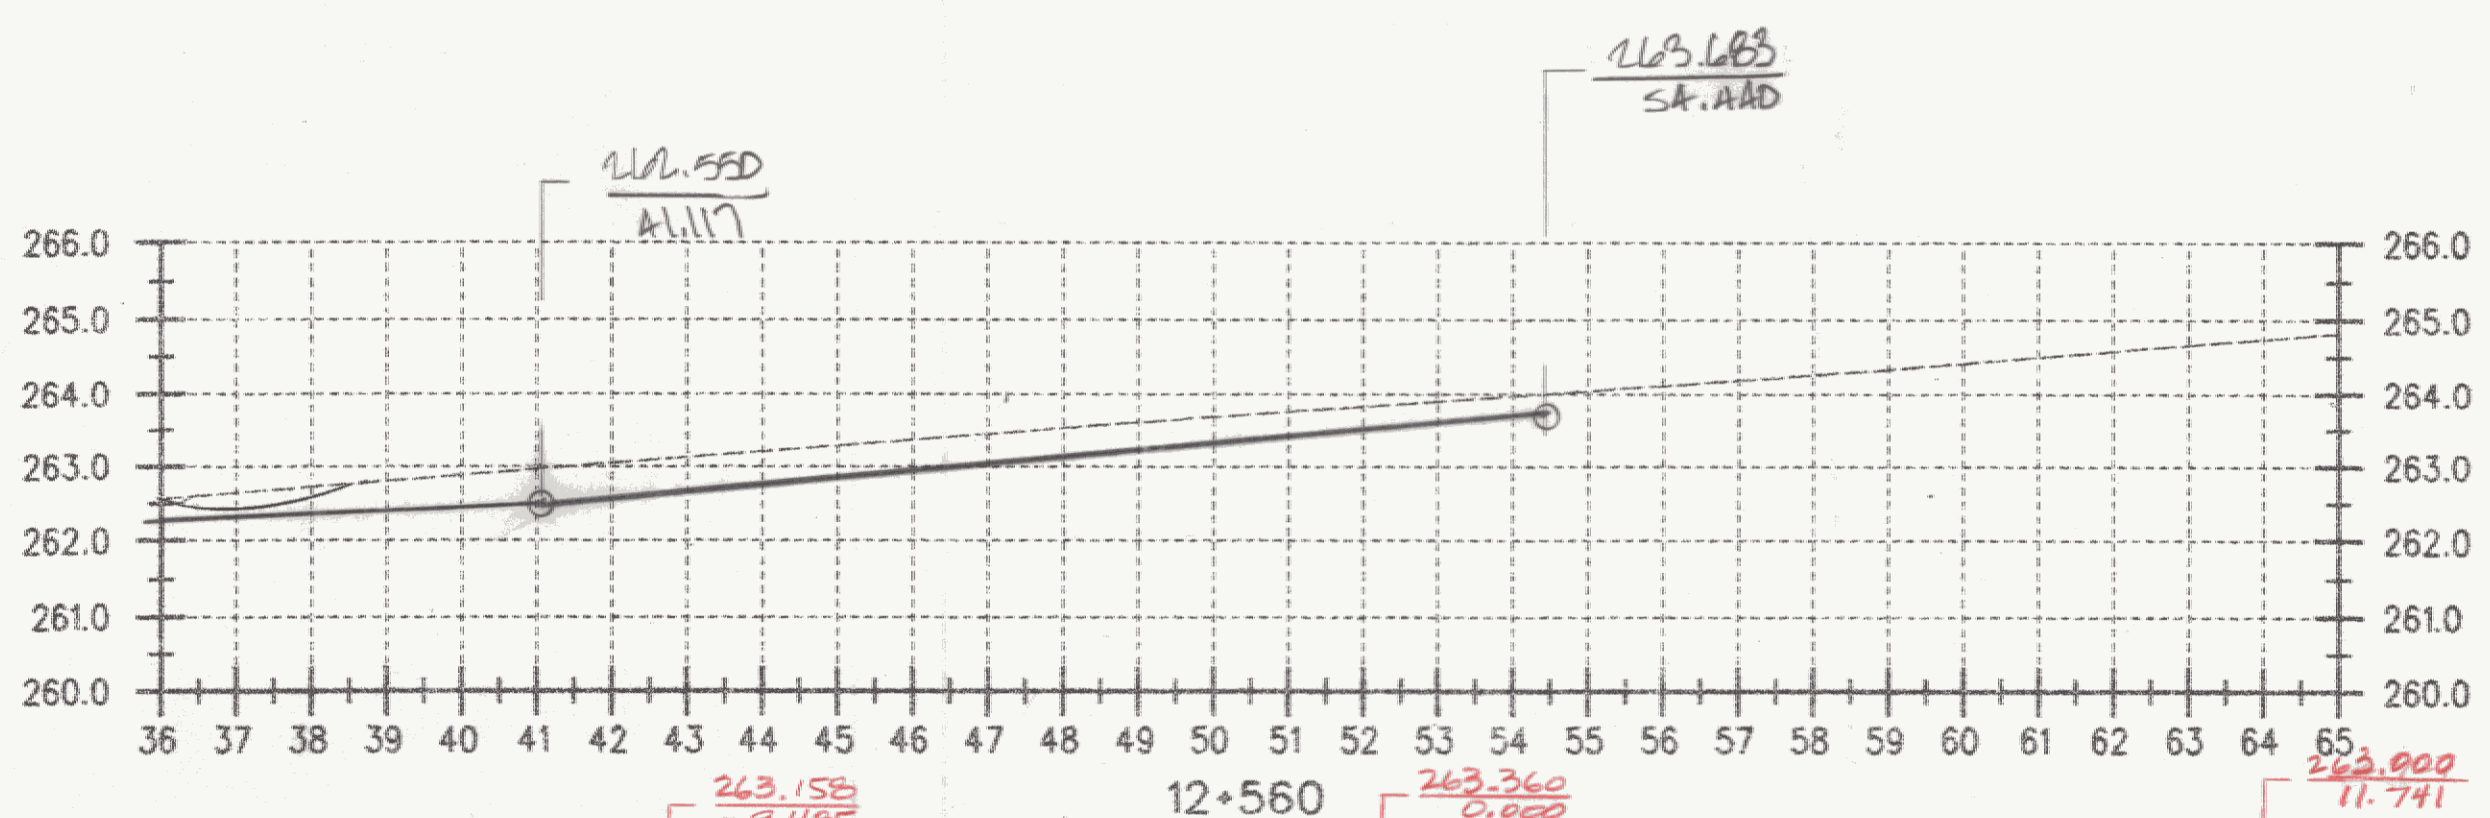

C=3
F=48
R=0

DATUM	
VERTICAL	NAVD 88
HORIZONTAL	NAD 83 (1992)

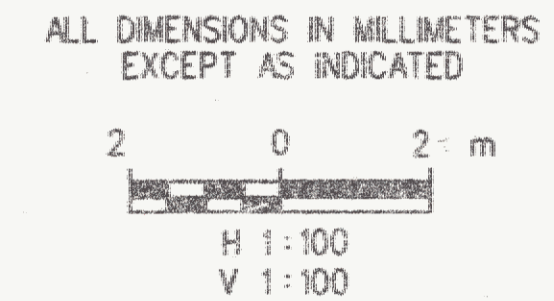

SURVEYED BY	C.H.A. & V.S.E.	DATE	
DRAWN BY	J.S.L.	DATE	
SQUAD LEADER	T.P.K.		
DESIGN FILE NO.	n/a		
IPARM FILE		DATE PLOTTED	
PROJ. NAME	BENNINGTON - HOOSICK		
	D.P.I. 0146(1) c/3		
PROJ. NO.	P.I.N. 1306.60.201		
SHEET	320 OF 473 SHEETS		