
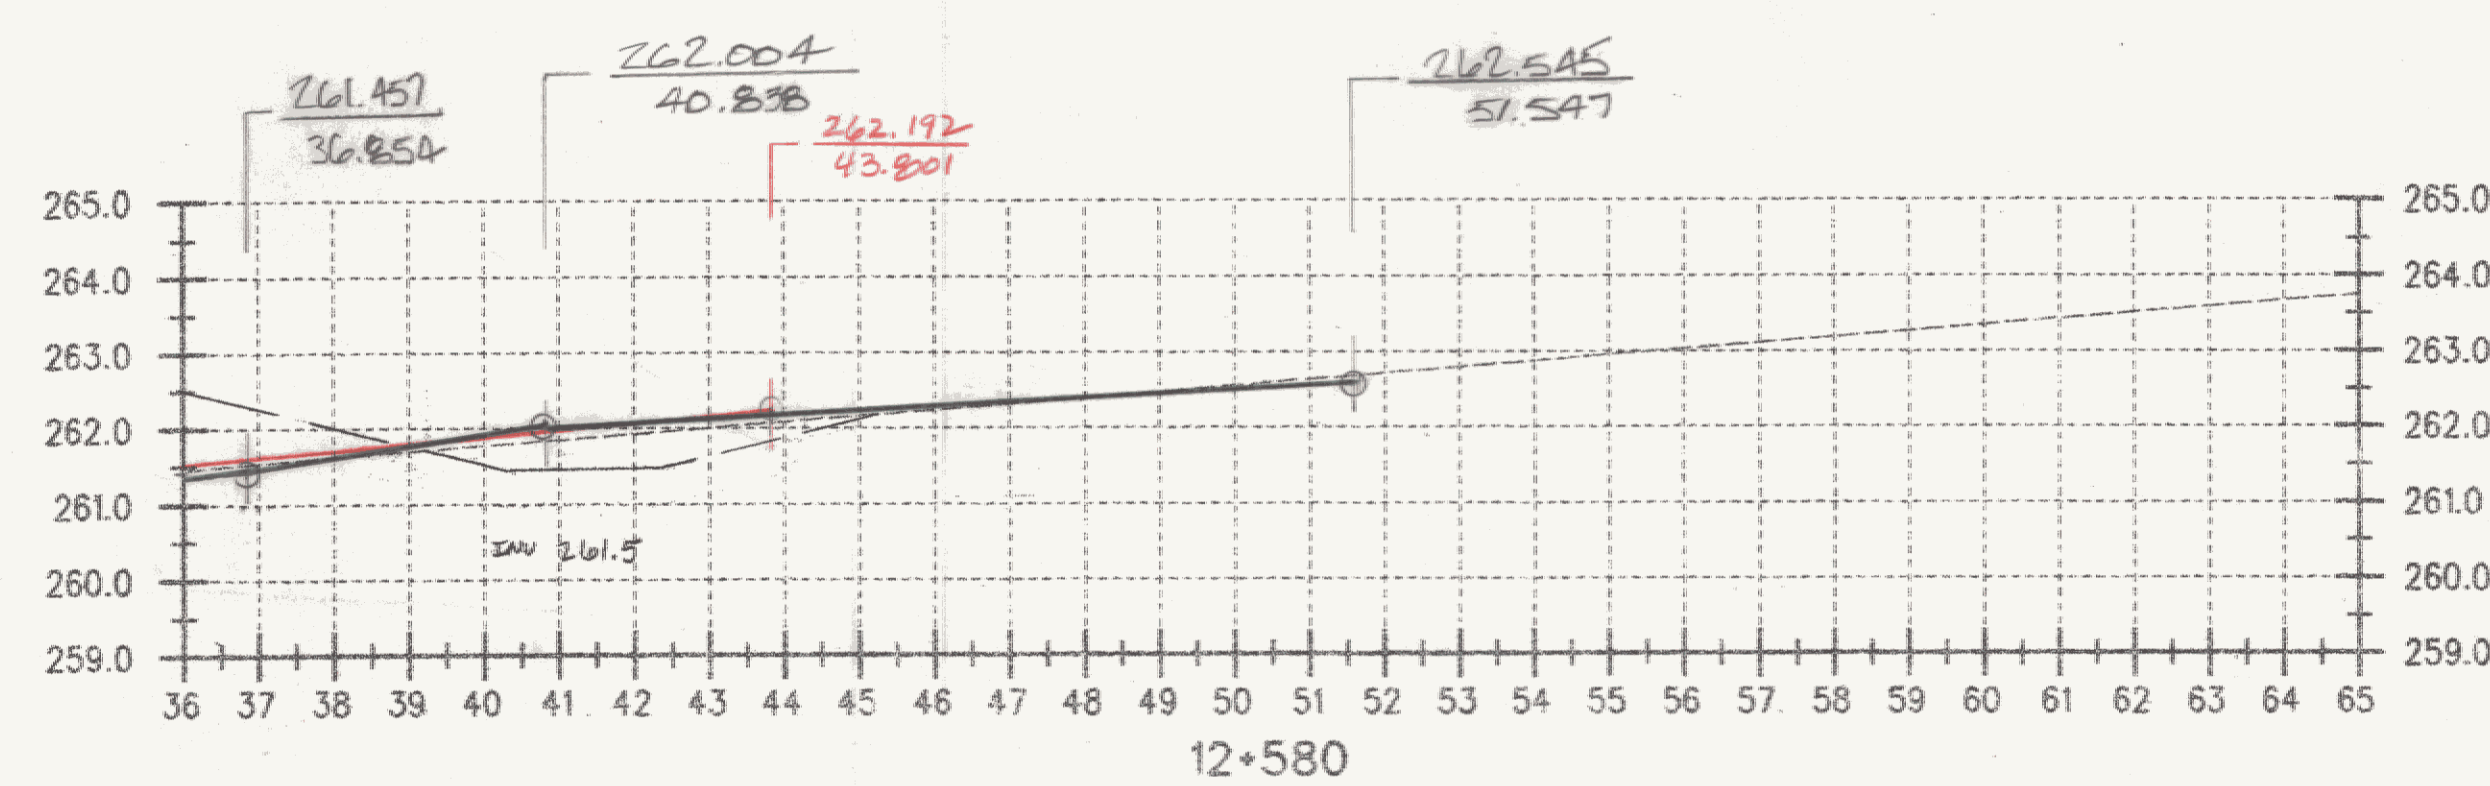


CG TD. C=0
 Back F=150-145.93
 FG. R=0
 R=0

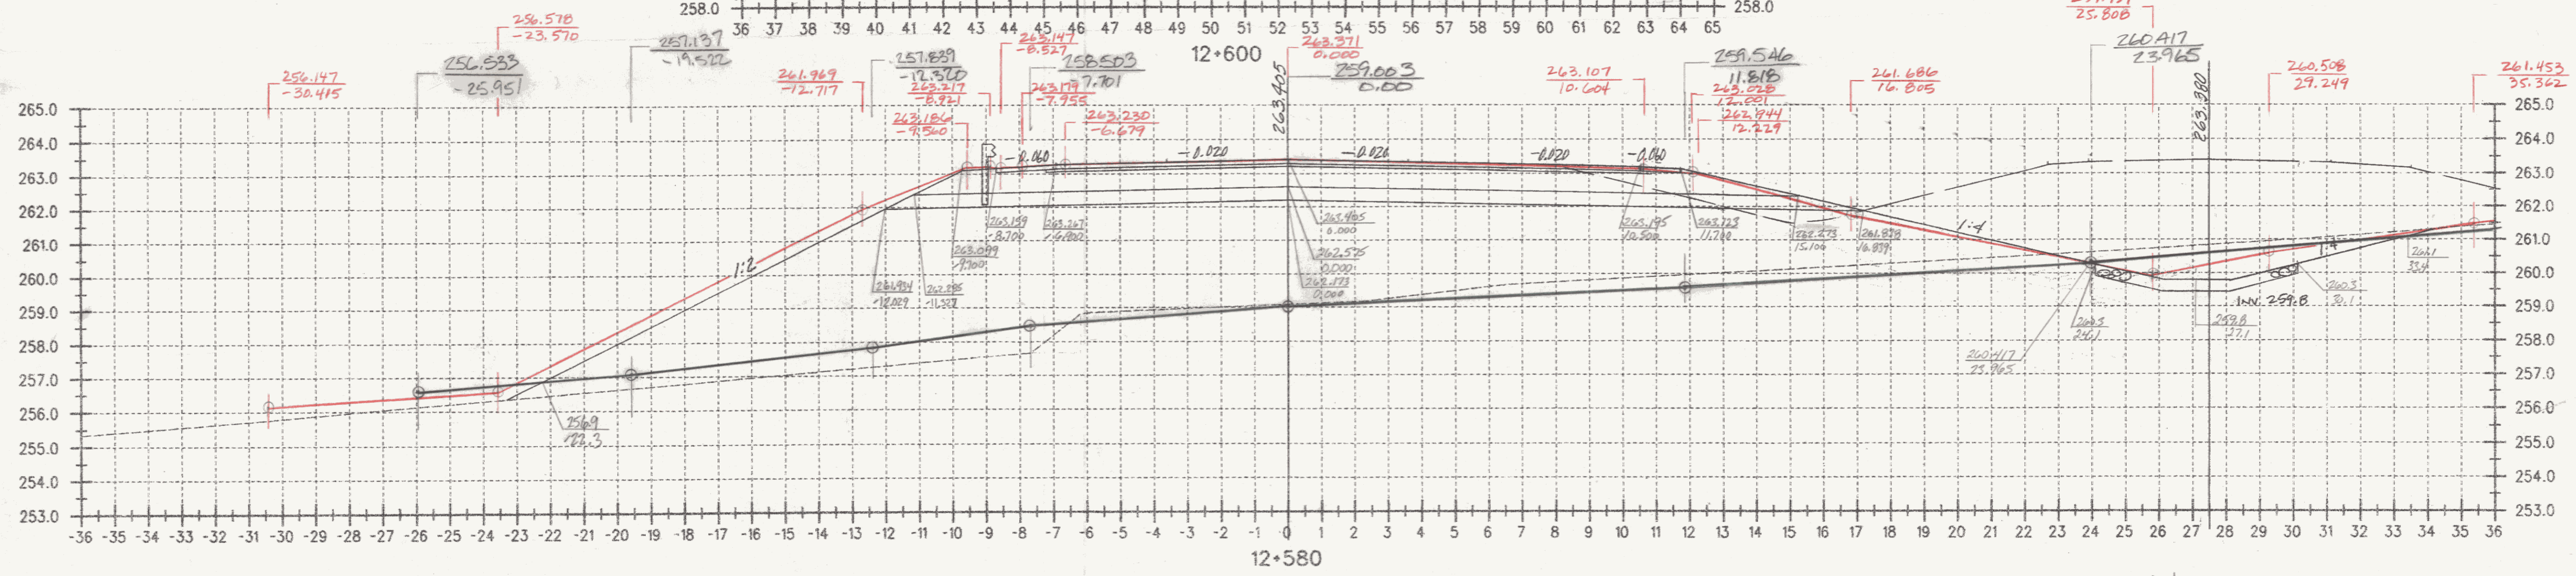

CG TD. C=5 4.50
 Back F=114 113.74
 FG. R=0
 R=0

DATUM
 VERTICAL NAVD 88
 HORIZONTAL NAD 83 (1992)

ALL DIMENSIONS IN MILLIMETERS EXCEPT AS INDICATED
 2 0 2 m
 H 1:100
 V 1:100

SURVEYED BY C.H.A. & V.S.E. DATE
 DRAWN BY J.S.L. DATE
 SQUAD LEADER T.P.K.
 DESIGN FILE NO. n/a
 IPARM DATE
 FILE PLOTTED
 PROJ. NAME BENNINGTON - HOOSICK
 D.P.I. 0146(1) c/3
 PROJ. NO. P.I.N. 1306.60.201
 SHEET 321 OF 473 SHEETS