


$C=7$ 6.76
 $F=147$ 150.87
 $R=0$

OG TP
 RMT
 FG. 3/22/05

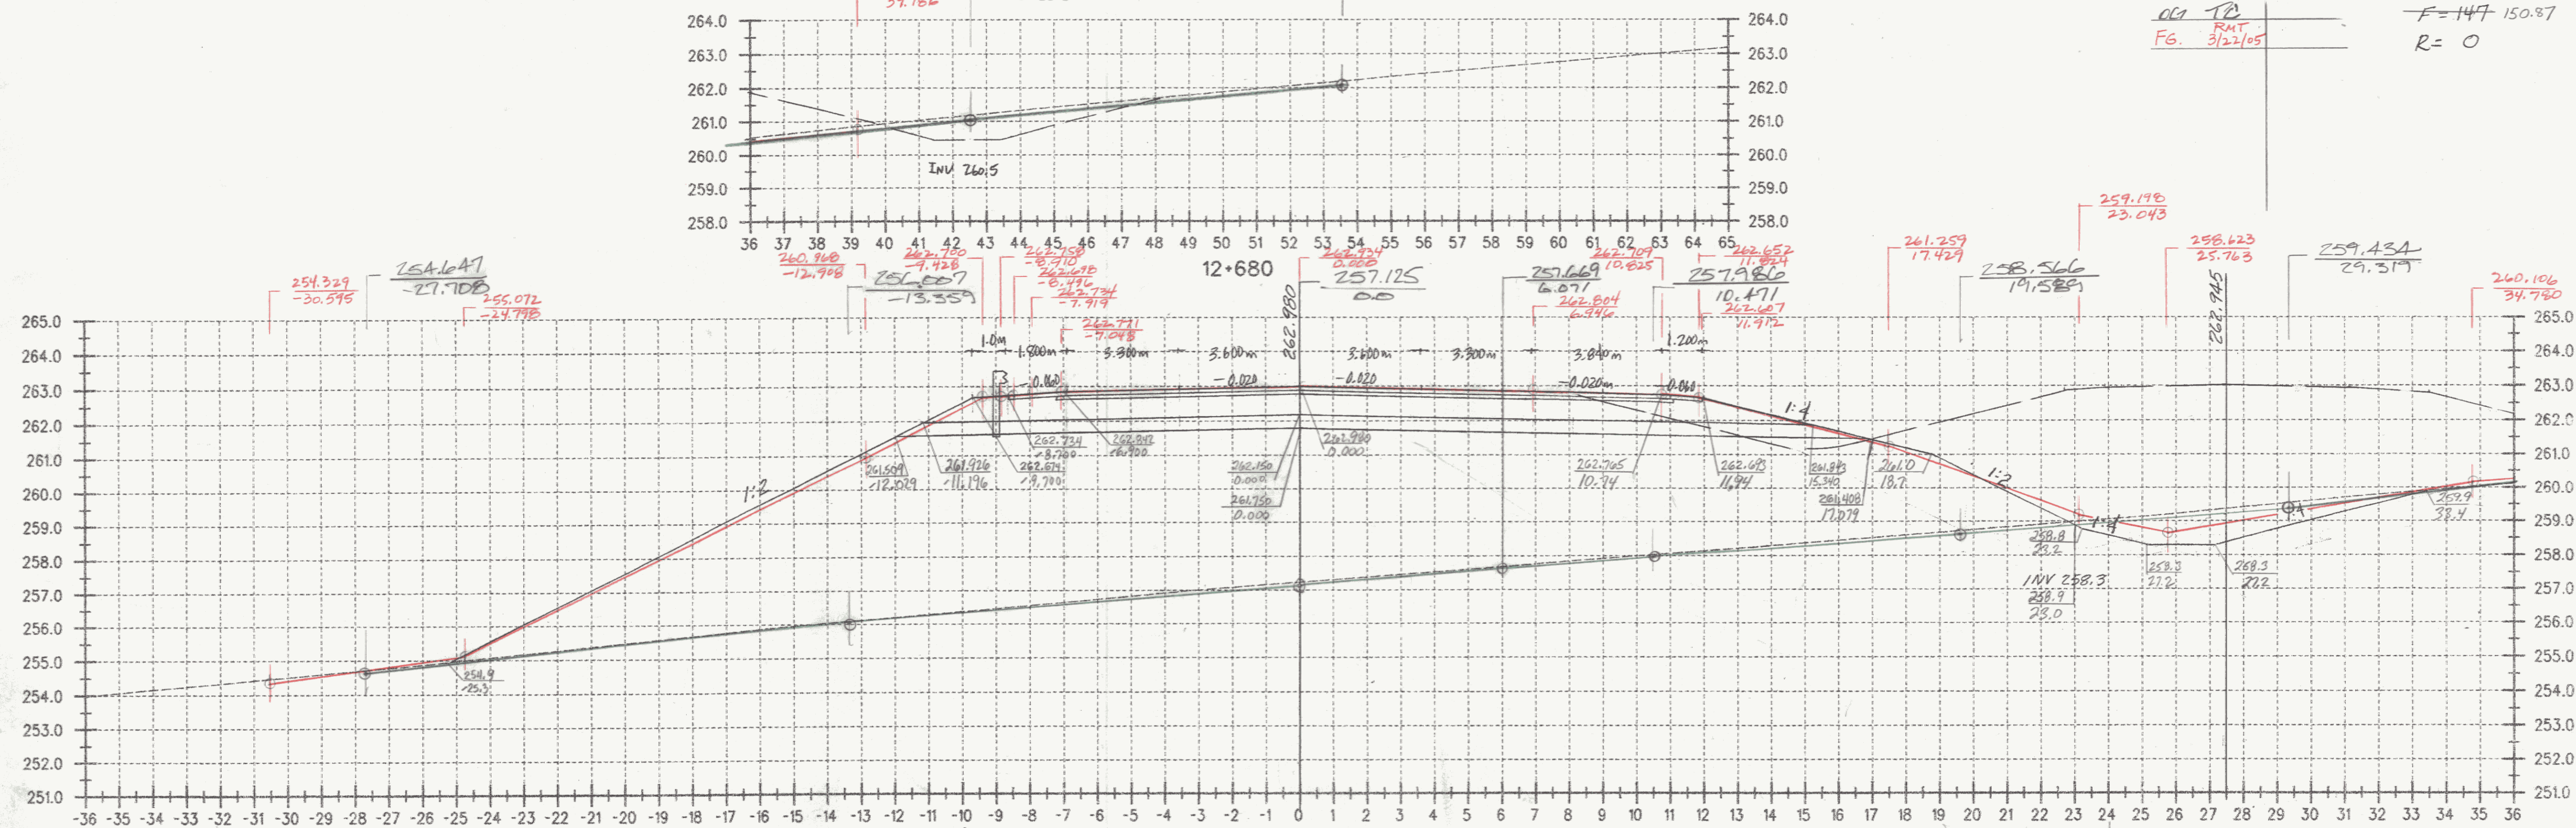

$C=6$ 4.99
 $F=167$ 170.05
 $R=0$

OG TP
 RMT
 FG. 3/22/05

DATUM
 VERTICAL NAVD 88
 HORIZONTAL NAD 83 (1992)

ALL DIMENSIONS IN MILLIMETERS
 EXCEPT AS INDICATED

2 0 2 m
 H 1:100
 V 1:100

SURVEYED BY C.H.A. & V.S.E. DATE _____
 DRAWN BY J.S.L. DATE _____
 SQUAD LEADER T.P.K.
 DESIGN FILE NO. n/a
 IPARM FILE _____ DATE PLOTTED _____
 PROJ. NAME BENNINGTON - HOOSICK
 D.P.I. 0146(1) C13
 PROJ. NO. P.I.N. 1306.60.201
 SHEET 324 of 473 SHEETS