


VIS A-4 Gr.SaSi
MTW or Very Hard
N=127
B.o.B 9.75M
B-322

C=14 12.50m²
F=125 137.62m²
R=0

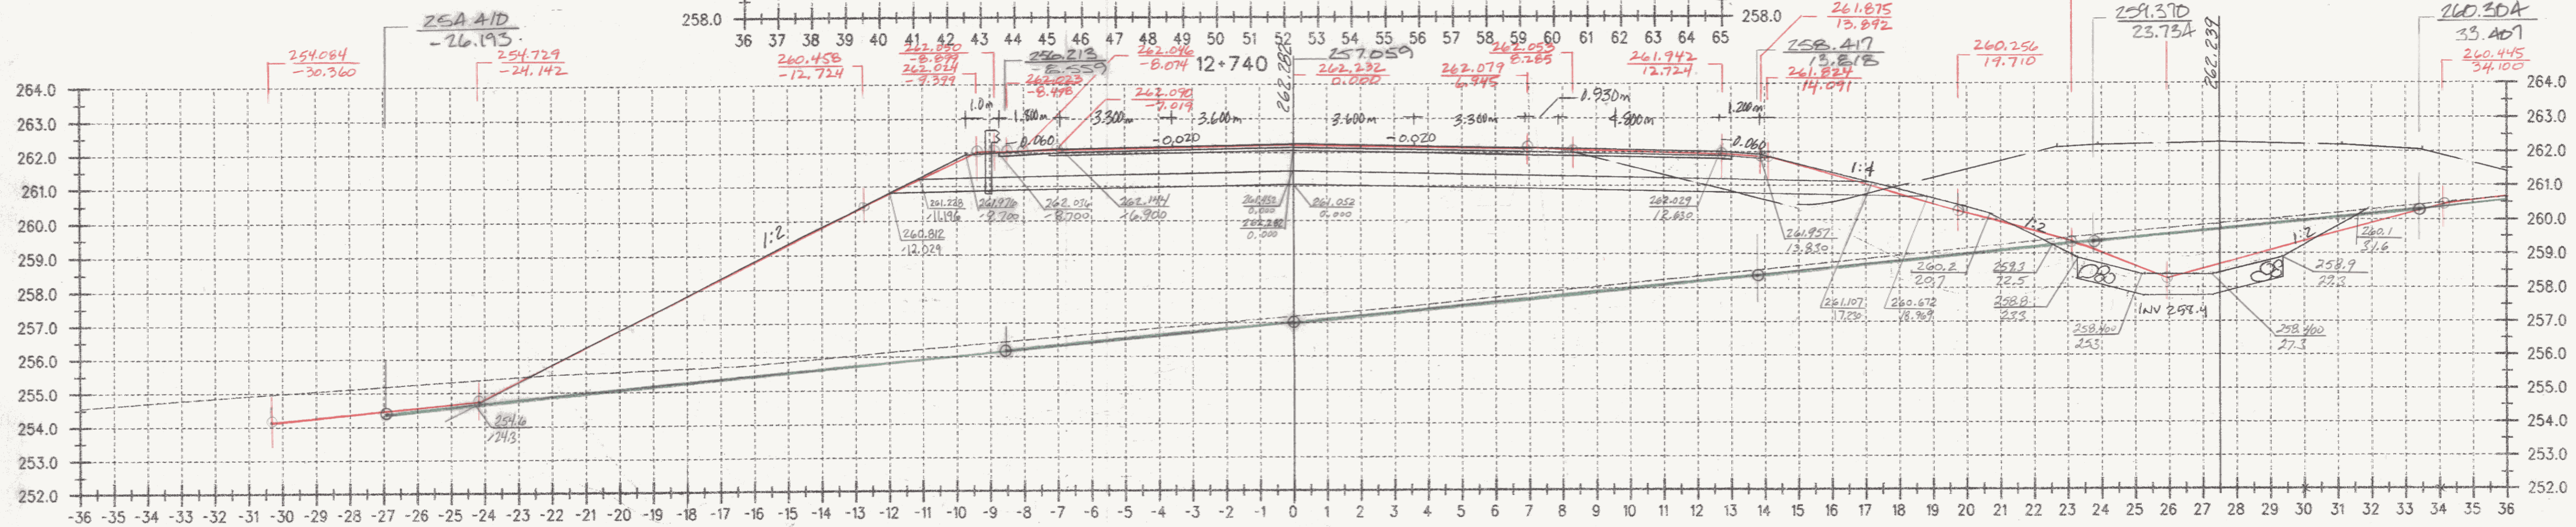


ZSA AID
-26.193
254.729
-24.142


C=9 7.70m²
F=132 141.98m²
R=0

DATUM

VERTICAL	NAVD 88
HORIZONTAL	NAD 83 (1992)

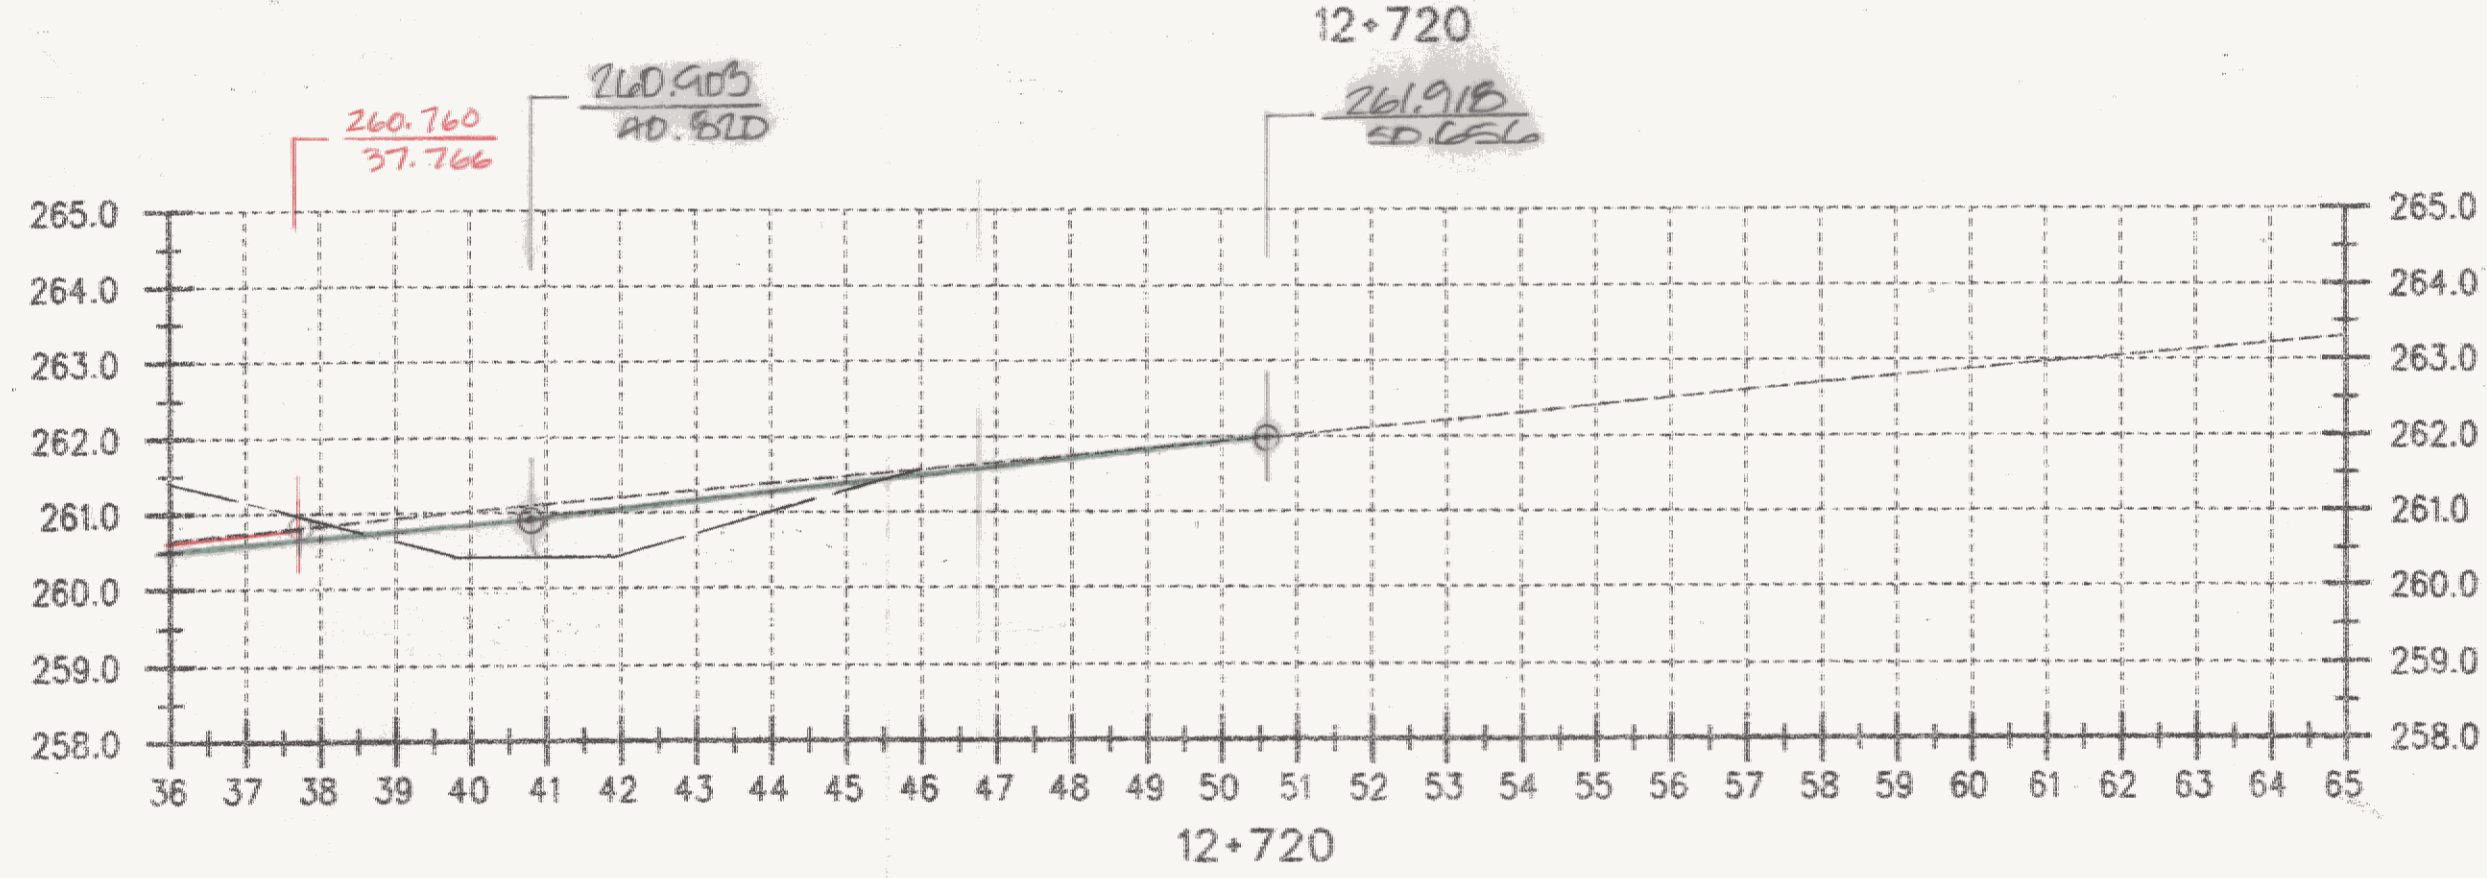

FG. RMT 3/22/05 ✓ JWS/SLB/05

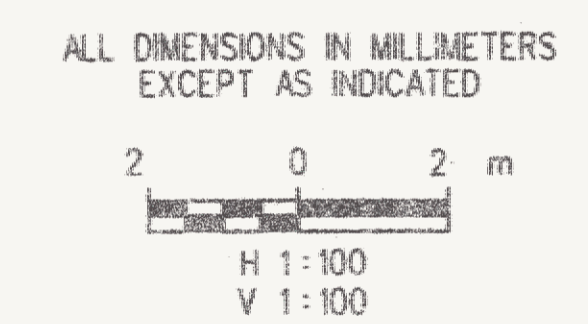

SURVEYED BY	C.H.A. & V.S.E.	DATE	
DRAWN BY	J.S.L.	DATE	
SQUAD LEADER	T.P.K.		
DESIGN FILE NO.	n/a		
IPARM FILE		DATE PLOTTED	
PROJ. NAME	BENNINGTON - HOOSICK		
	D.P.I. 0146(1) c13		
PROJ. NO.	P.I.N. 1306.60.201		
SHEET	326 OF 473 SHEETS		