


C = 472
 F = 1
 R = 318

FG. Rut 110bs ✓

DATUM	
VERTICAL	NAVD 88
HORIZONTAL	NAD 83 (1992)

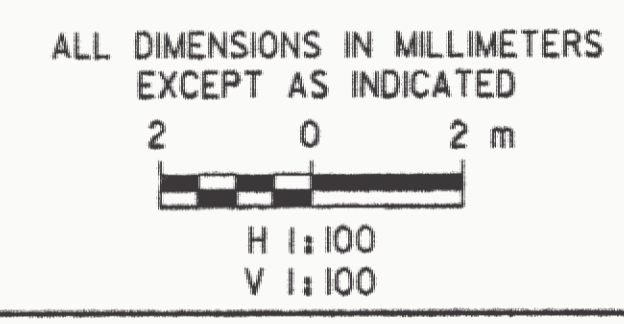

SURVEYED BY	C.H.A. & V.S.E.	DATE	12/93
DRAWN BY	J.S.L.	DATE	7/01
SQUAD LEADER	T.P.K.	REV.	01/02
DESIGN FILE NO.	/5116/VAOT/VTSECT4.D		
IPARM FILE	DATE PLOTTED		
PROJ. NAME	BENNINGTON - HOOSICK D.P.I. 0146(1) C/3		
PROJ. NO.	P.I.N. 1306.60		
SHEET	335 OF 473 SHEETS		