


DATUM	
VERTICAL	NAVD 1985
HORIZONTAL	N/A

O.G.  
Box 11/1/03  
104P  
F.G. RMT ✓  
12L

SEE REVISED SHEET # 336,  
DATED 08/02 (ATTACHED)  
RMT 11/01/05

$C = 160$   
 $F = 2 \cdot 1.38 + 1.69 = 3.07m^2$   
 $R = 525$   
 $231.72 + 149.85 + 18.95 = 1699.90 SM$

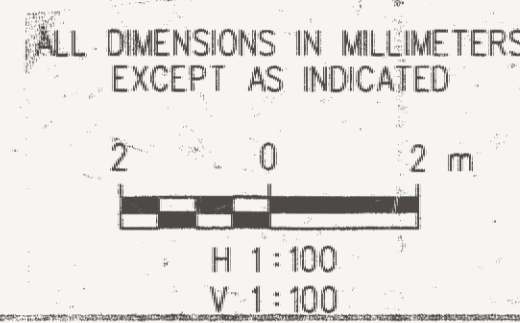

SURVEYED BY	C.H.A. & V.S.E.	DATE	
DRAWN BY	J.S.L.	DATE	
SQUAD LEADER	T.P.K.		
DESIGN FILE NO.	N/A		
IFARM FILE		DATE PLOTTED	
PROJ. NAME	BENNINGTON - HOOSICK		
	D.P.I. 0146(1) c/3		
PROJ. NO.	P.I.N. 1306.60.201		
SHEET	336 OF 473 SHEETS		