


DATUM
 VERTICAL NAVD 1988
 HORIZONTAL N/A

FG. RMT 1/24/05 ✓ TEL

C = 760
 F = 2
 R = 525

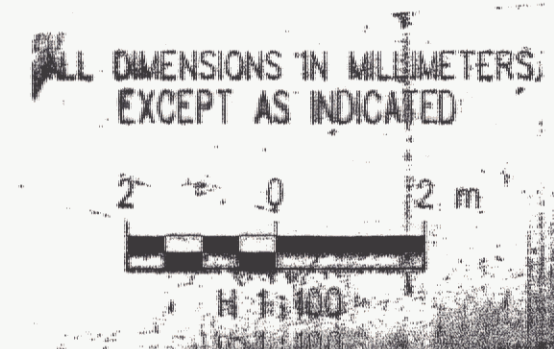

SURVEYED BY C.H.A. & V.S.E. DATE
 DRAWN BY J.S.L. DATE
 SQUAD LEADER T.P.K. Rev 08/02
 DESIGN FILE NO. N/A Rev. 01/03
 I.P.A.R.M. FILE DATE PLOTTED RMT 1/24/05
 PROJ. NAME BENNINGTON - HOOSICK
 D.P.I. 04660 C/S
 PROJ. NO. P.I.N. 1306.00.201
 SHEET 33 OF 173 SHEETS