


13+020

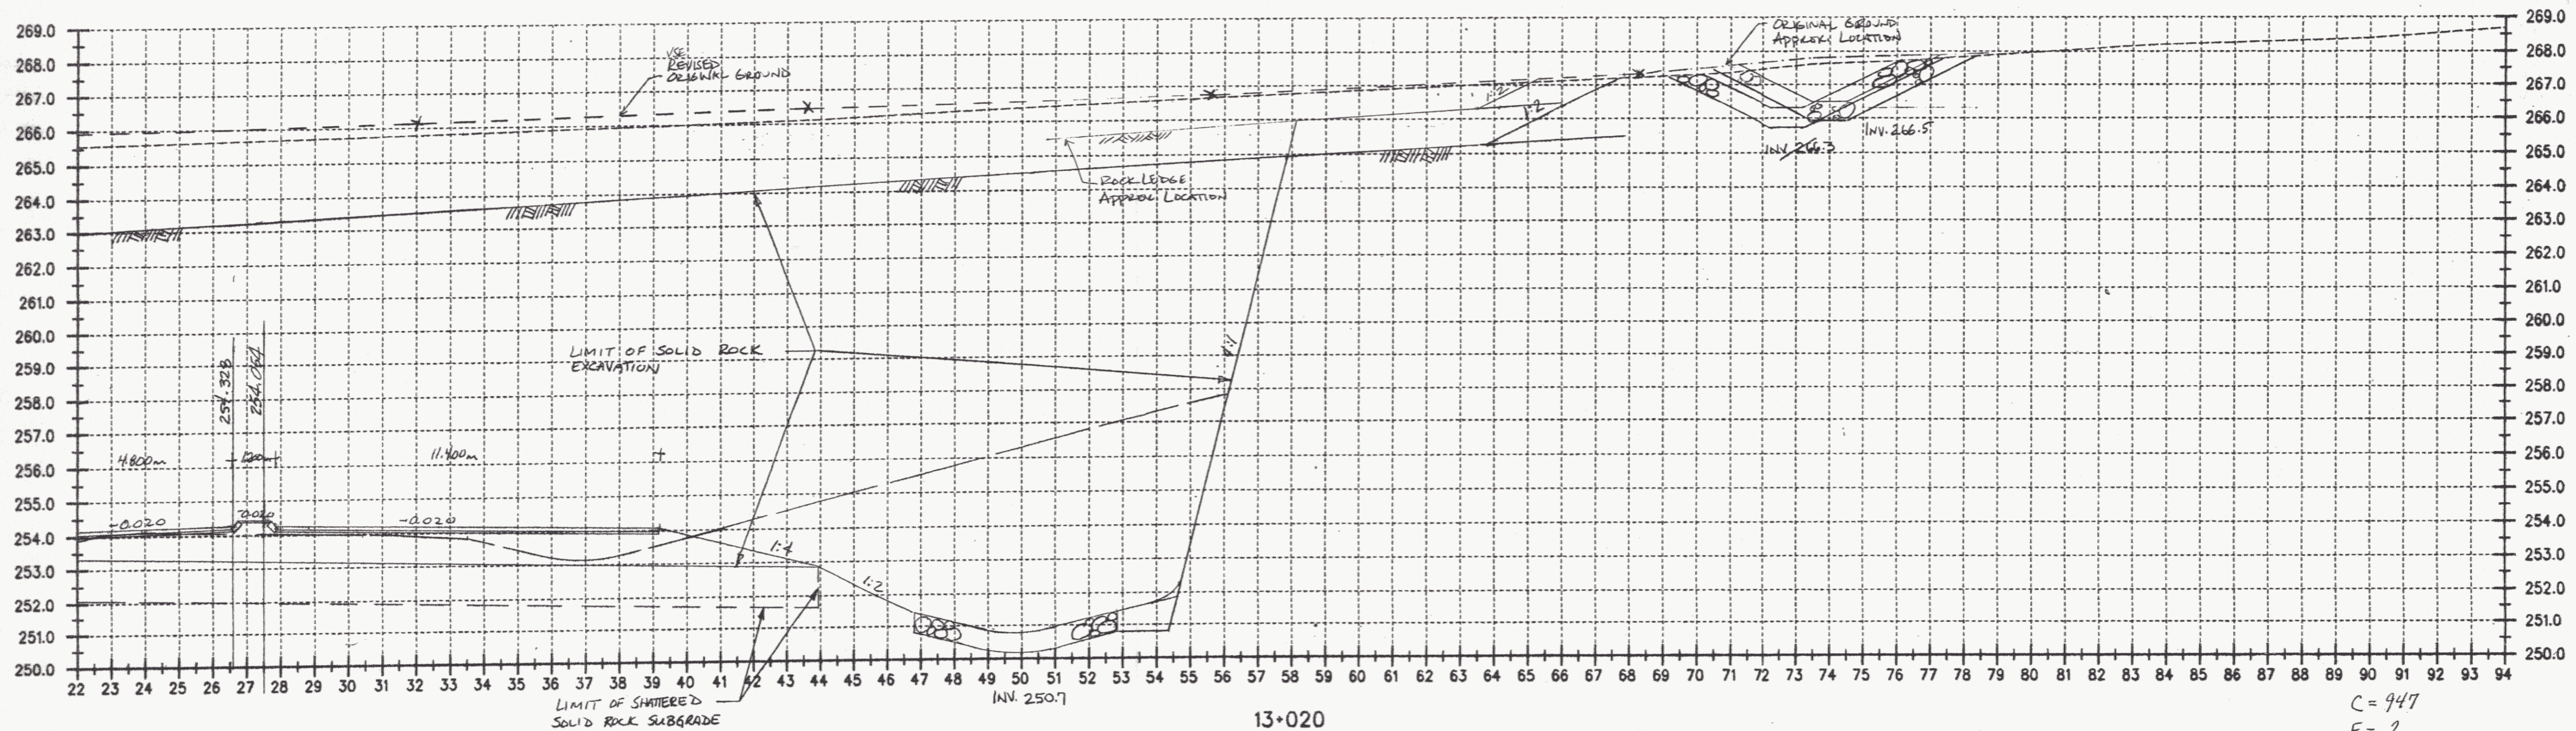


13+020

C = 947  
F = 2  
R = 750

DATUM	
VERTICAL	NAVD 1988
HORIZONTAL	N/A

FG. RMT 1/24/05

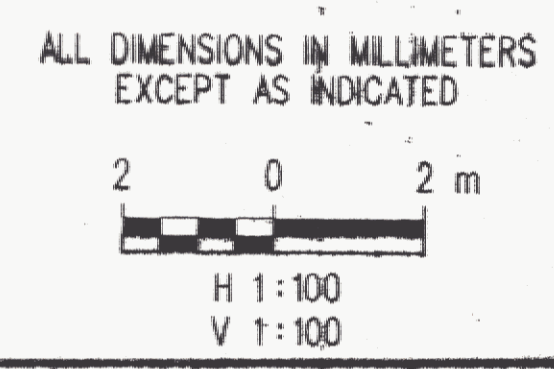

SURVEYED BY	C.H.A. & V.S.E.	DATE	
DRAWN BY	J.S.L.	DATE	
SQUAD LEADER	T.P.K.	REV.	05/02
DESIGN FILE NO.	N/A	REV.	01/03
FILE		DATE PLOTTED	RMT 1/24/05
PROJ. NAME	BENNINGTON - HOOSICK D.P.I. 0146(1) C13		
PROJ. NO.	P.I.N. 1306.60.201		
SHEET	337 OF 473 SHEETS		