


SEE REVISED SHEET # 339,
DATED 01/03 (ATTACHED)
RMT 1/24/05

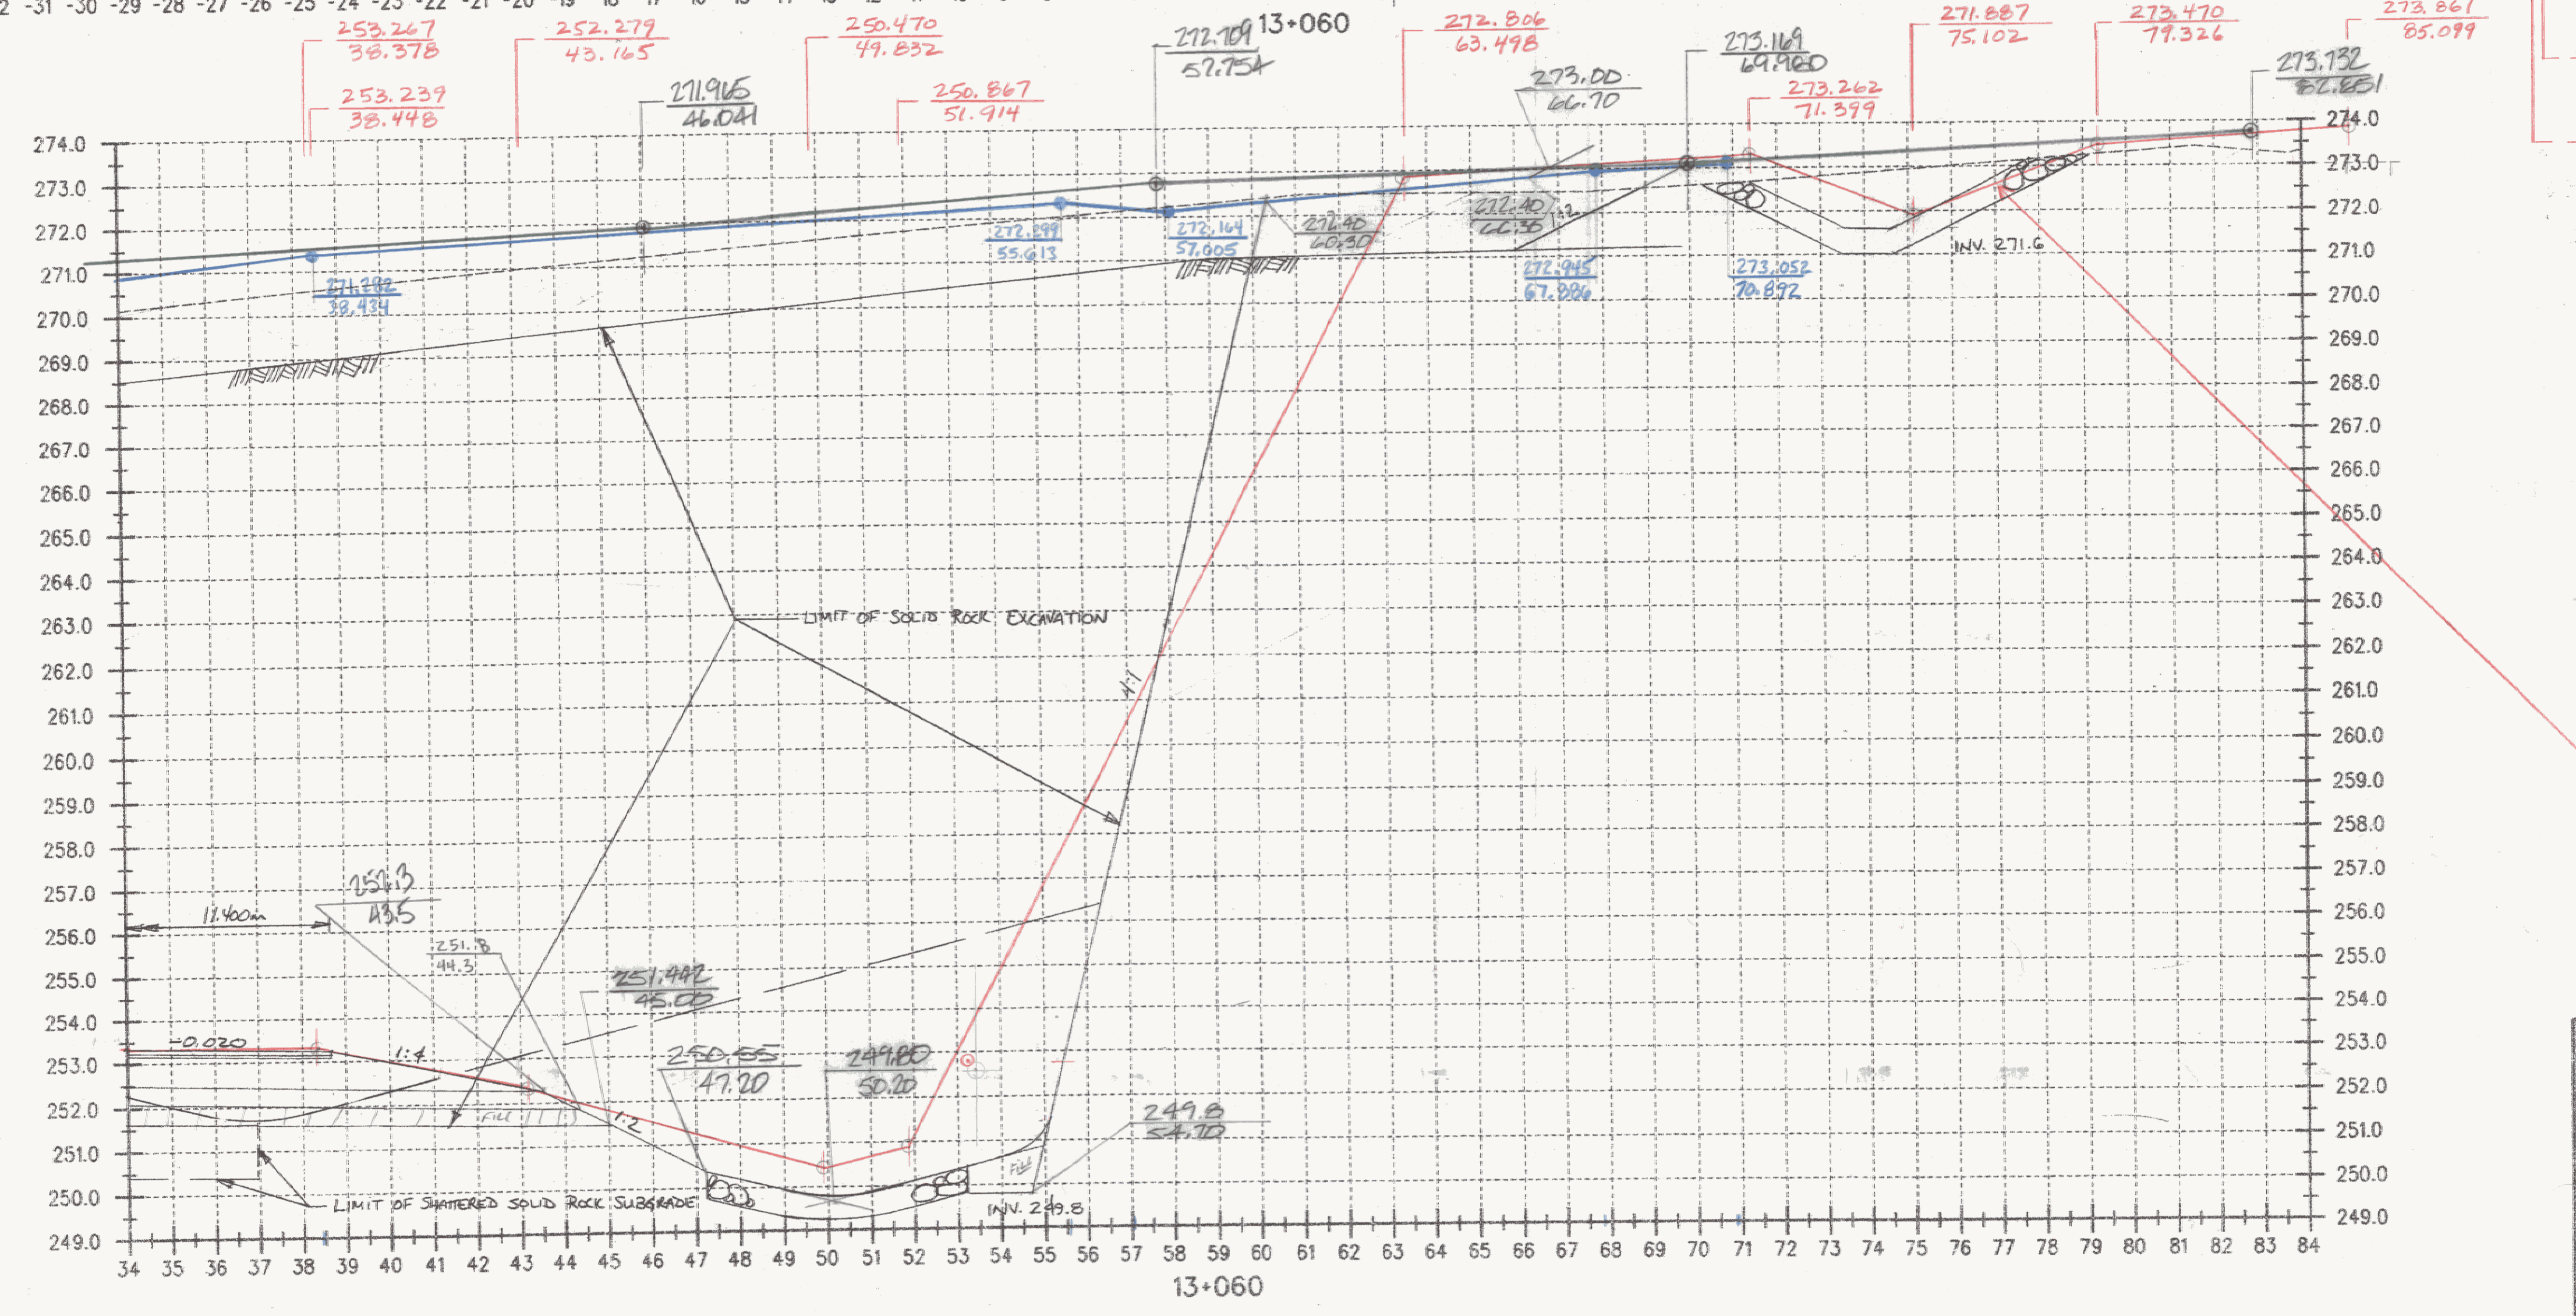

$C = 1358$
 $F = 17 \ 15.65$
 $R = 1207 \ 1394.916$
 BY RRM
 Z-19-03
 Rock 1/17/03
 FG RMT 1/10/05
 SEE REVISED SHEET # 339,
 DATED 06/02 (ATTACHED)
 RMT 1/11/05

ALL DIMENSIONS IN MILLIMETERS
 EXCEPT AS INDICATED
 2 0 2 m
 H 1:100
 V 1:100

DATUM
 VERTICAL NAVD 88
 HORIZONTAL NAD 83 (1992)

SURVEYED BY C.H.A. & V.S.E. DATE 6/95
 DESIGNED BY D.E.G. DATE 6/95
 DRAWN BY J.S.L. DATE 6/95
 CHECKED BY T.P.K. DATE 6/95
 DESIGN FILE NO. N/A
 PROJ. NAME BENNINGTON - HOOSICK
 D.P.I. 0146(1) C/3
 PROJ. NO. P.I.N. 1306.60.201
 SHEET 339 OF 473 DWG No.