


13+060

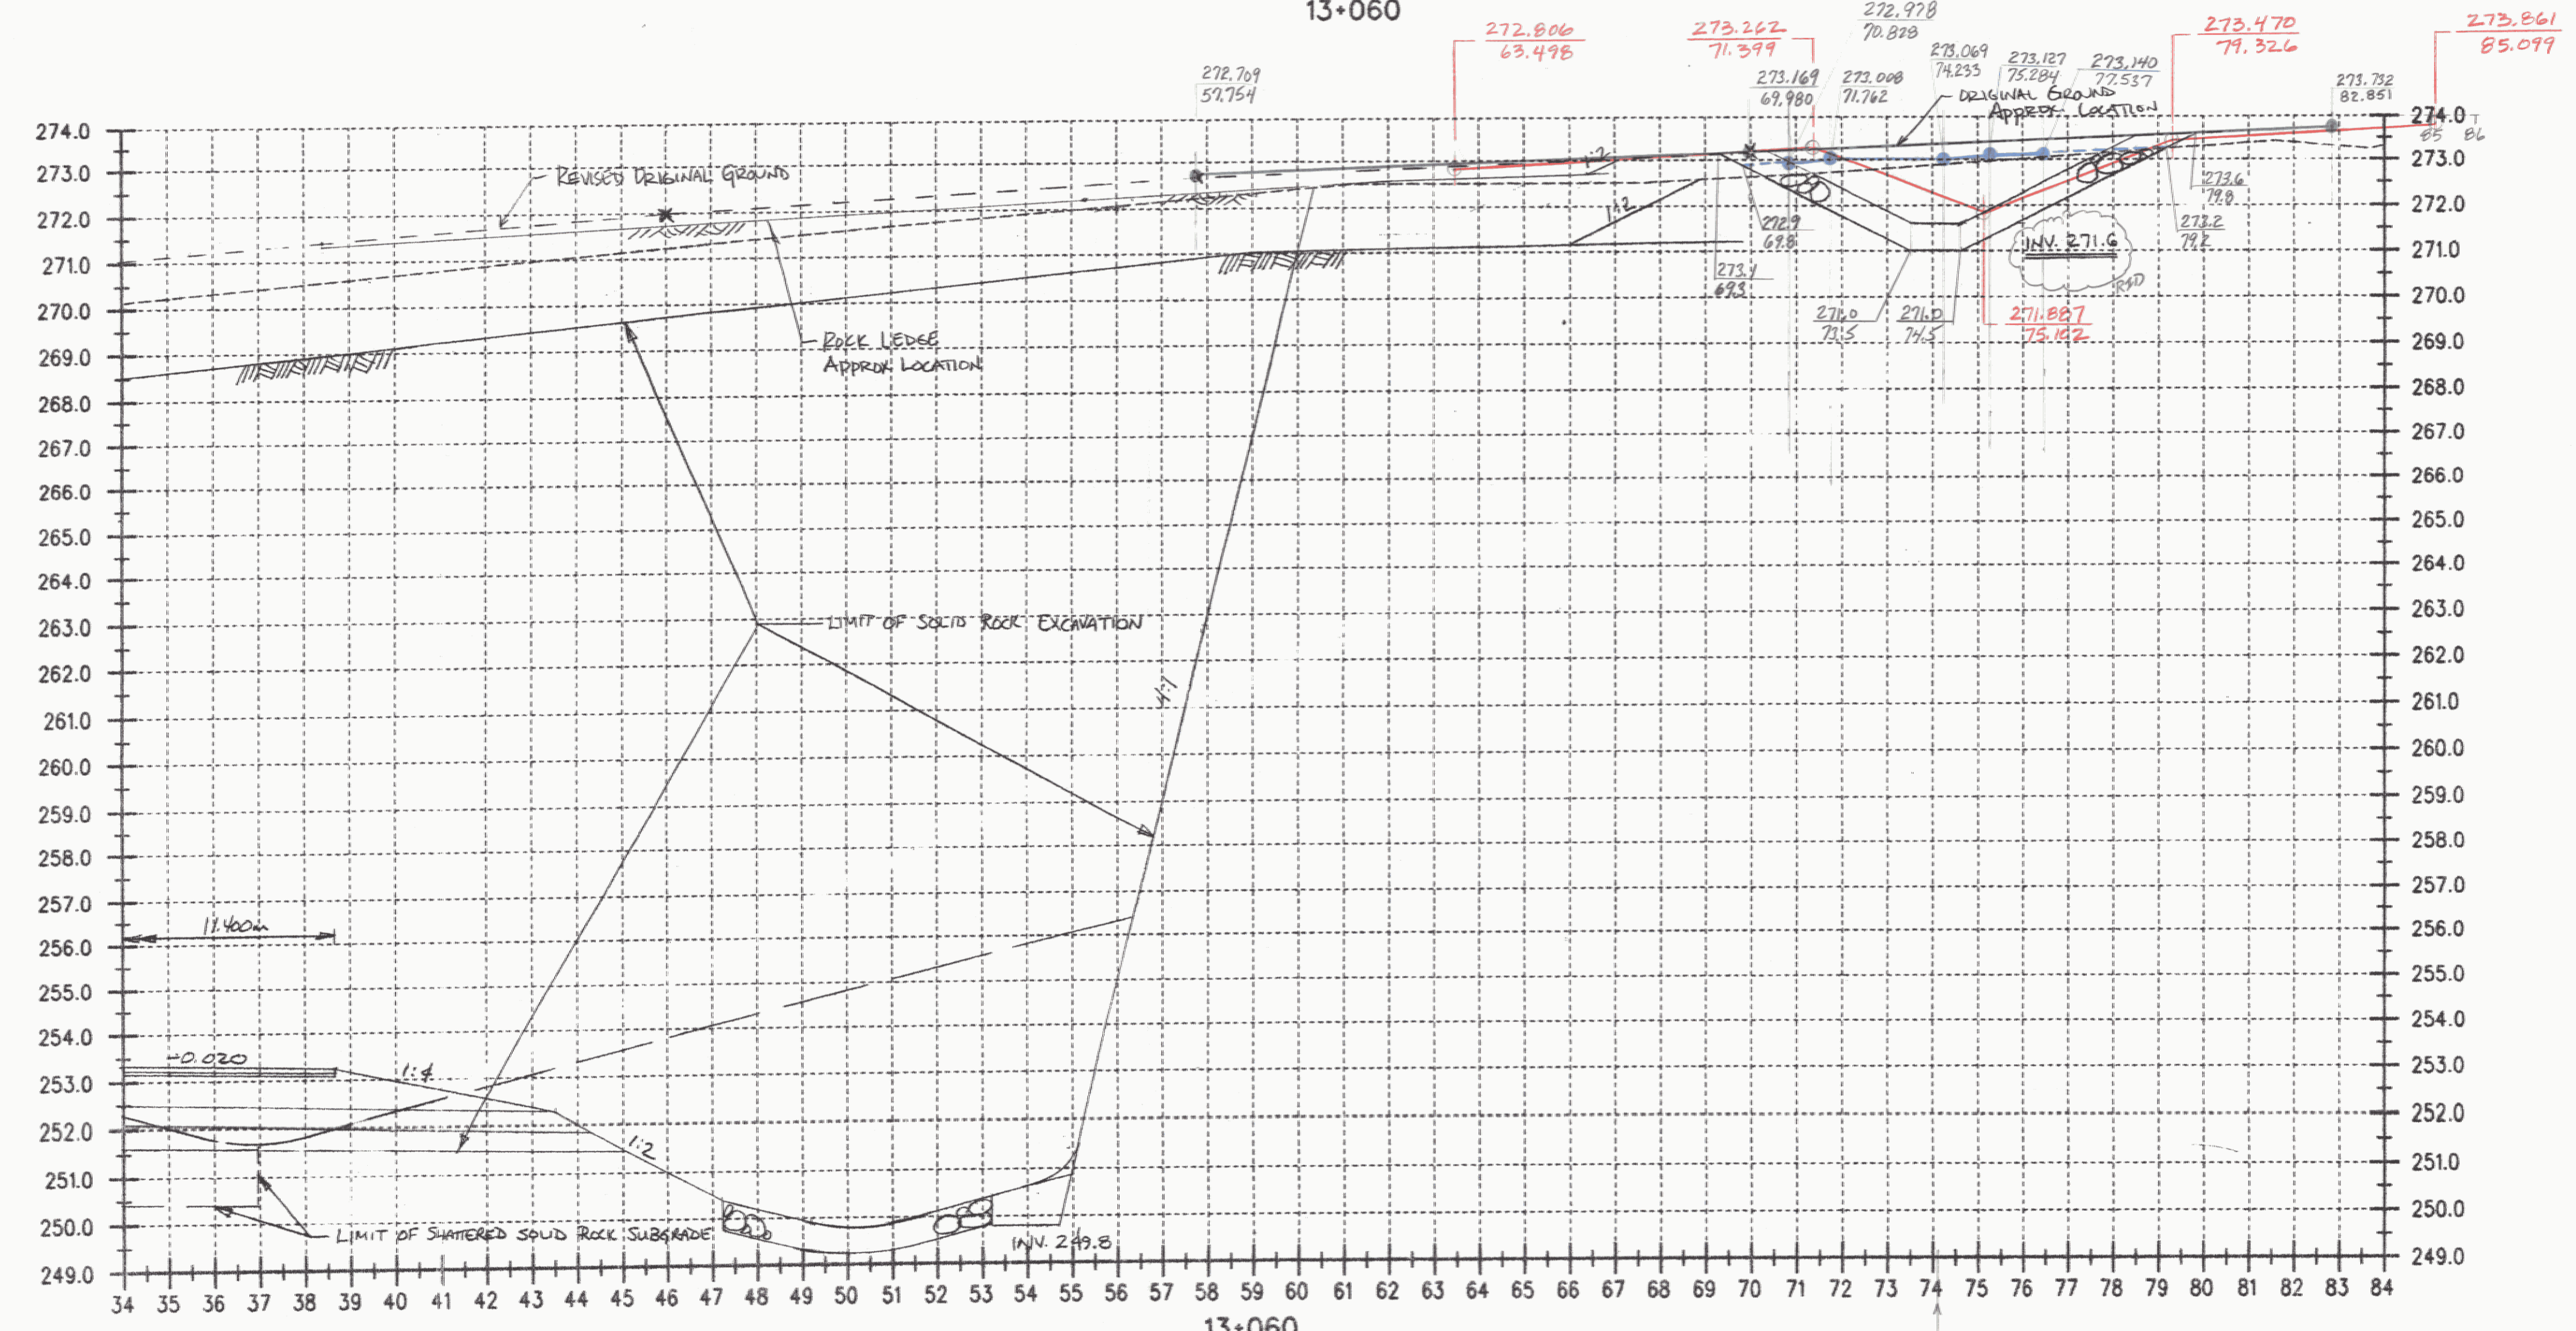

13+060

C = 1358  
F = 17  
R = 1207

FG. RMT 11/1/95

ALL DIMENSIONS IN MILLIMETERS EXCEPT AS INDICATED  
  
 H 1:100  
 V 1:100

DATUM  
 VERTICAL NAVD 88  
 HORIZONTAL NAD 83 (1982)

SURVEYED BY C.H.A. & V.S.E. DATE 6/95  
 DESIGNED BY D.E.G. DATE 6/95  
 DRAWN BY J.S.L. DATE 6/95  
 CHECKED BY T.P.K. DATE 6/95  
 DESIGN FILE NO. N/A  
 PROJ. NAME BENNINGTON - HOOSICK  
 D.P.I. 0146(1) C/3  
 PROJ. NO. P.I.N. 1306.60.201  
 SHEET 399 OF 473 DWG No. -

PRD