


FG. RMT 11/105 ✓

C = 1487
 F = 36
 R = 1344

ALL DIMENSIONS IN MILLIMETERS EXCEPT AS INDICATED

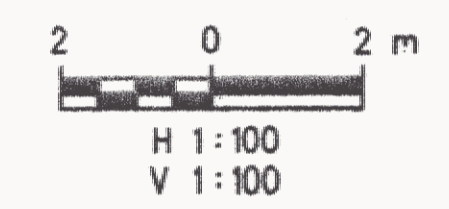

SURVEYED BY C.H.A. & V.S.E. DATE 6/95
 DESIGNED BY D.E.G. DATE 6/95
 DRAWN BY J.S.L. DATE 6/95
 CHECKED BY T.P.K. DATE 6/95
 Rev. 02/02

DESIGN FILE NO. N/A

PROJ. NAME BENNINGTON - HOOSICK
 D.P.I. 0146(1) C/3
 PROJ. NO. P.I.N. 1306.60.201
 SHEET 31 OF 473 DWG. No. -

Metric

DATUM
 VERTICAL NAVD 88
 HORIZONTAL NAD 83 (1992)

13+100

RSD