


FG. RMT 1/24/05 ✓

C = 1487
F = 36
R = 1344

ALL DIMENSIONS IN MILLIMETERS EXCEPT AS INDICATED

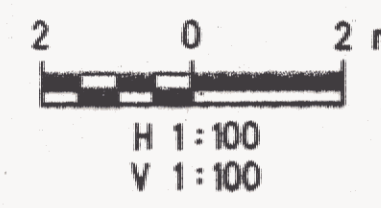

Metric

DATUM
VERTICAL NAVD 88
HORIZONTAL NAD 83 (1992)

SURVEYED BY C.H.A. & V.S.E.	DATE 6/95
DESIGNED BY D.E.G.	DATE 6/95
DRAWN BY J.S.L.	DATE 6/95
CHECKED BY T.P.K.	DATE 6/95
DESIGN FILE NO. N/A	REV. 01/03 RMT 1/24/05
PROJ. NAME BENNINGTON - HOOSICK D.P.I. 0146(1) C/3	
PROJ. NO. P.I.N. 1306.60.201	
SHEET 341 OF 473	DWG No. -