


13+120

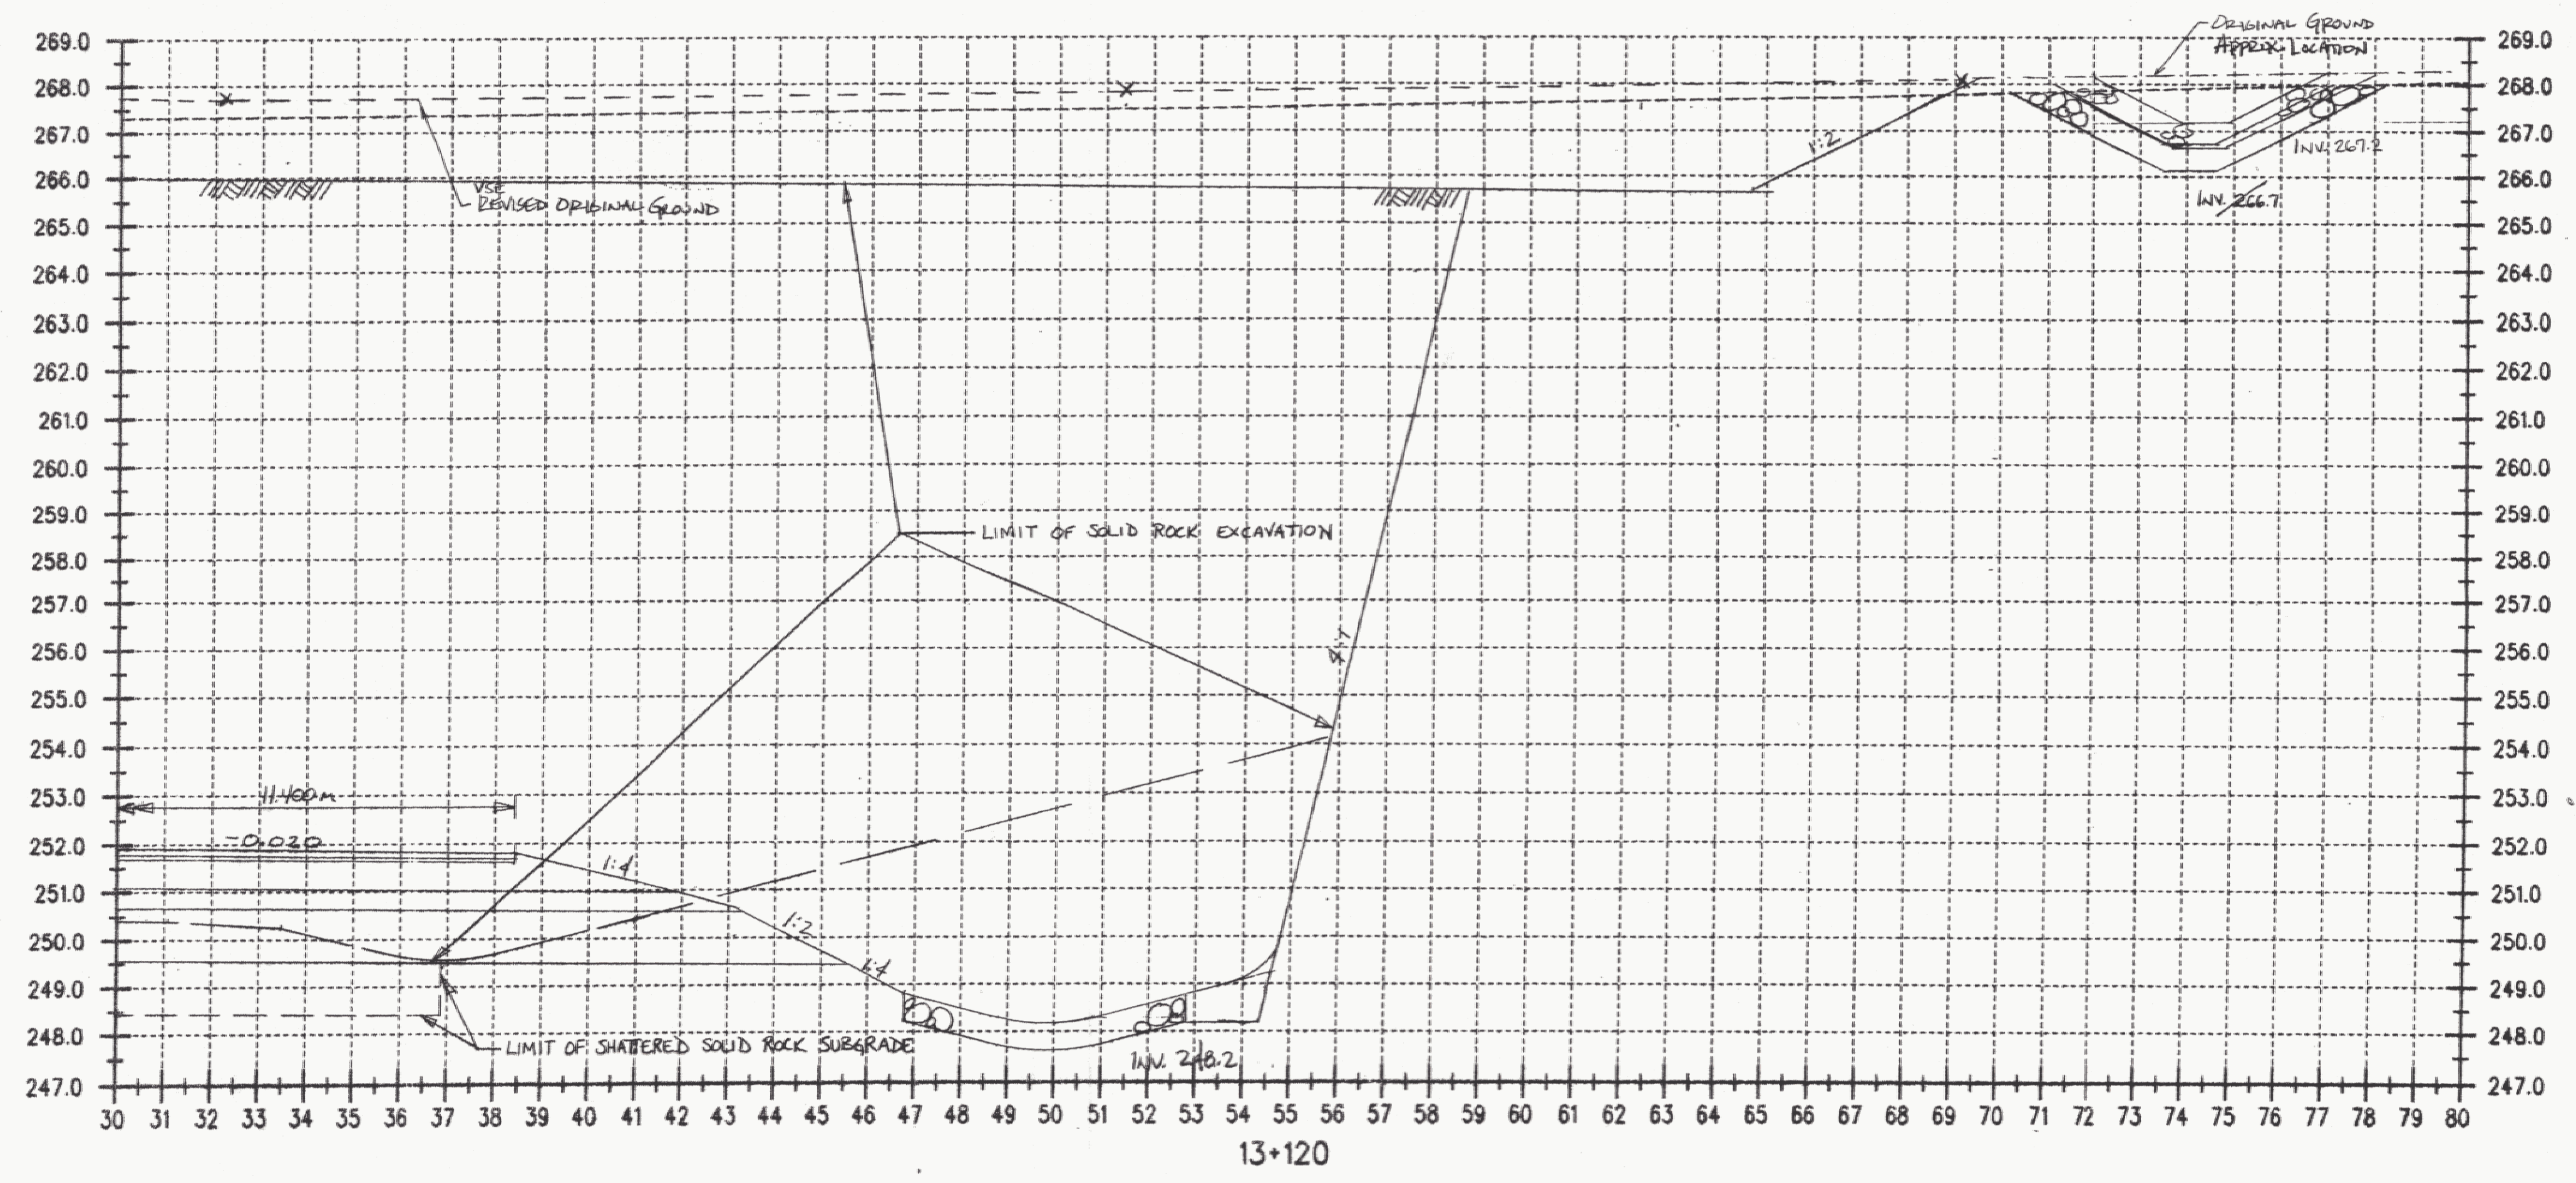


13+120

DATUM	
VERTICAL	NAVD 88
HORIZONTAL	NAD 83 (1982)

FG. RMT 1/24/05 ✓  
JSL

C = 1444  
F = 43  
R = 1171

ALL DIMENSIONS IN MILLIMETERS EXCEPT AS INDICATED

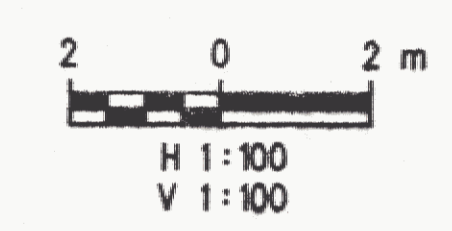

SURVEYED BY	C.H.A. & V.S.E.	DATE	6/95
DESIGNED BY	D.E.G.	DATE	6/95
DRAWN BY	J.S.L.	DATE	6/95
CHECKED BY	T.P.K.	DATE	6/95
DESIGN FILE NO.	N/A	REV. 08/92	RMT 1/24/05
PROJ. NAME	BENNINGTON - HOOSICK D.P.I. 0146(1) C/3		
PROJ. NO.	P.I.N. 1306.60.201		
SHEET	342 OF 473	DWG. No.	-