

20.0
2.0
14.7


251.17
 $C = 1238 - (49.4) + 187.70$
 $F = 44(2.64 + 33.74) = 38.31$
 $R = 914 / 1529.21$

Metric

DATUM
 VERTICAL NAVD 1988
 HORIZONTAL N/A

20.91m P.C.S
 P = 353
 S.P.A 13+150

DLA T.D. RRM
 P.C.S. R.M.T. RRM
 FG R.M.T. 11/105 ✓ JFW/V/S

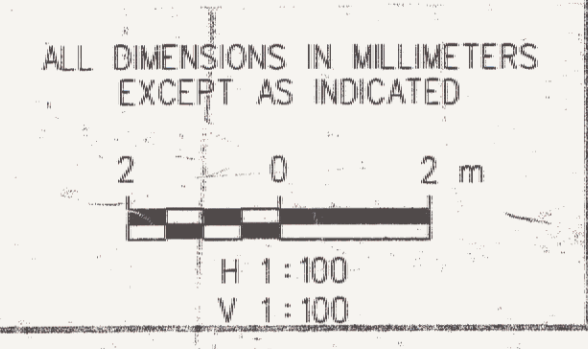

SURVEYED BY	C.H.A. & V.S.E.	DATE	
DRAWN BY	J.S.L.	DATE	
SQUAD LEADER	T.P.K.		
DESIGN FILE NO.	N/A		
PARM FILE		DATE PLOTTED	
PROJ. NAME	BENNINGTON - HOOSICK		
	D.P.I. 0146(1) c/3		
PROJ. NO.	P.I.N. 1306.60.201		
SHEET	343 OF 473 SHEETS		