


C = 1238  
 F = 41  
 R = 914

FG RMT 11/2/05

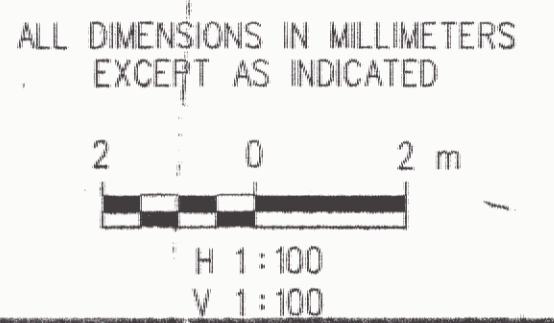

SURVEYED BY	C.H.A. & V.S.E.	DATE	
DRAWN BY	J.S.L.	DATE	
SQUAD LEADER	T.P.K.	REV. OF	05
DESIGN FILE NO.	N/A		
IPARM FILE	DATE PLOTTED		
PROJ. NAME	BENNINGTON - HOOSICK		
PROJ. NO.	D.P.I. 0146(1) C/3		
SHEET	343 OF 473 SHEETS		

**Metric**

DATUM  
 VERTICAL NAVD 1988  
 HORIZONTAL N/A

RSD