


Metric

DATUM
 VERTICAL NAVD 1988
 HORIZONTAL N/A

F.G. ^{RM} 12/1/05

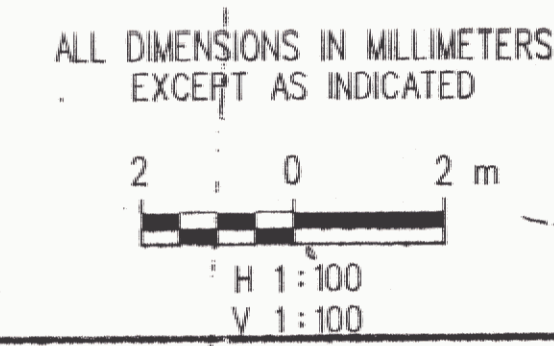

| | |
|---------------------------------|--------------------|
| SURVEYED BY C.H.A. & V.S.E. | DATE |
| DRAWN BY J.S.L. | DATE |
| SQUAD LEADER T.P.K. | REV. 01/03 |
| DESIGN FILE NO. N/A | RM 12/1/05 |
| IPARM FILE | DATE PLOTTED |
| PROJ. NAME BENNINGTON - HOOSICK | D.P.I. 0146(1) c/3 |
| PROJ. NO. P.I.N. 1306.60.201 | REV. 01/03 |
| SHEET 343 OF 473 SHEETS | RM 12/1/05 |

C = 1238
 F = 41
 R = 914