


DATUM
 VERTICAL NAVD 1988
 HORIZONTAL N/A

Plor By J.M. 10/25/02
 Check By J.P.W.
 Rock Plot by J.M. 11/10/02
 Check by J.P.W.
 FG RMT 1/10/05

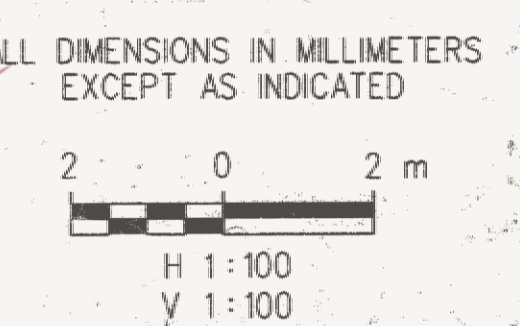

SURVEYED BY C.H.A. & V.S.E. DATE _____
 DRAWN BY J.S.L. DATE _____
 SQUAD LEADER T.P.K.
 DESIGN FILE NO. N/A
 IPARM FILE _____ DATE PLOTTED _____
 PROJ. NAME BENNINGTON - HOOSICK
 D.P.I. 0146(1) C/3 STA 13716.0
 PROJ. NO. P.I.N. 1306.60 201
 SHEET 344 OF 473 SHEETS

$C = 1140(118.56 + 115.12) = 255.68$
 $F = 60(297 + 2,04 + 57.5) = 48.58$
 $R = 1026 \quad 980.3$