


SEE REVISED SHEET #345, DATED 01/03 (ATTACHED) RMT 1/24/05

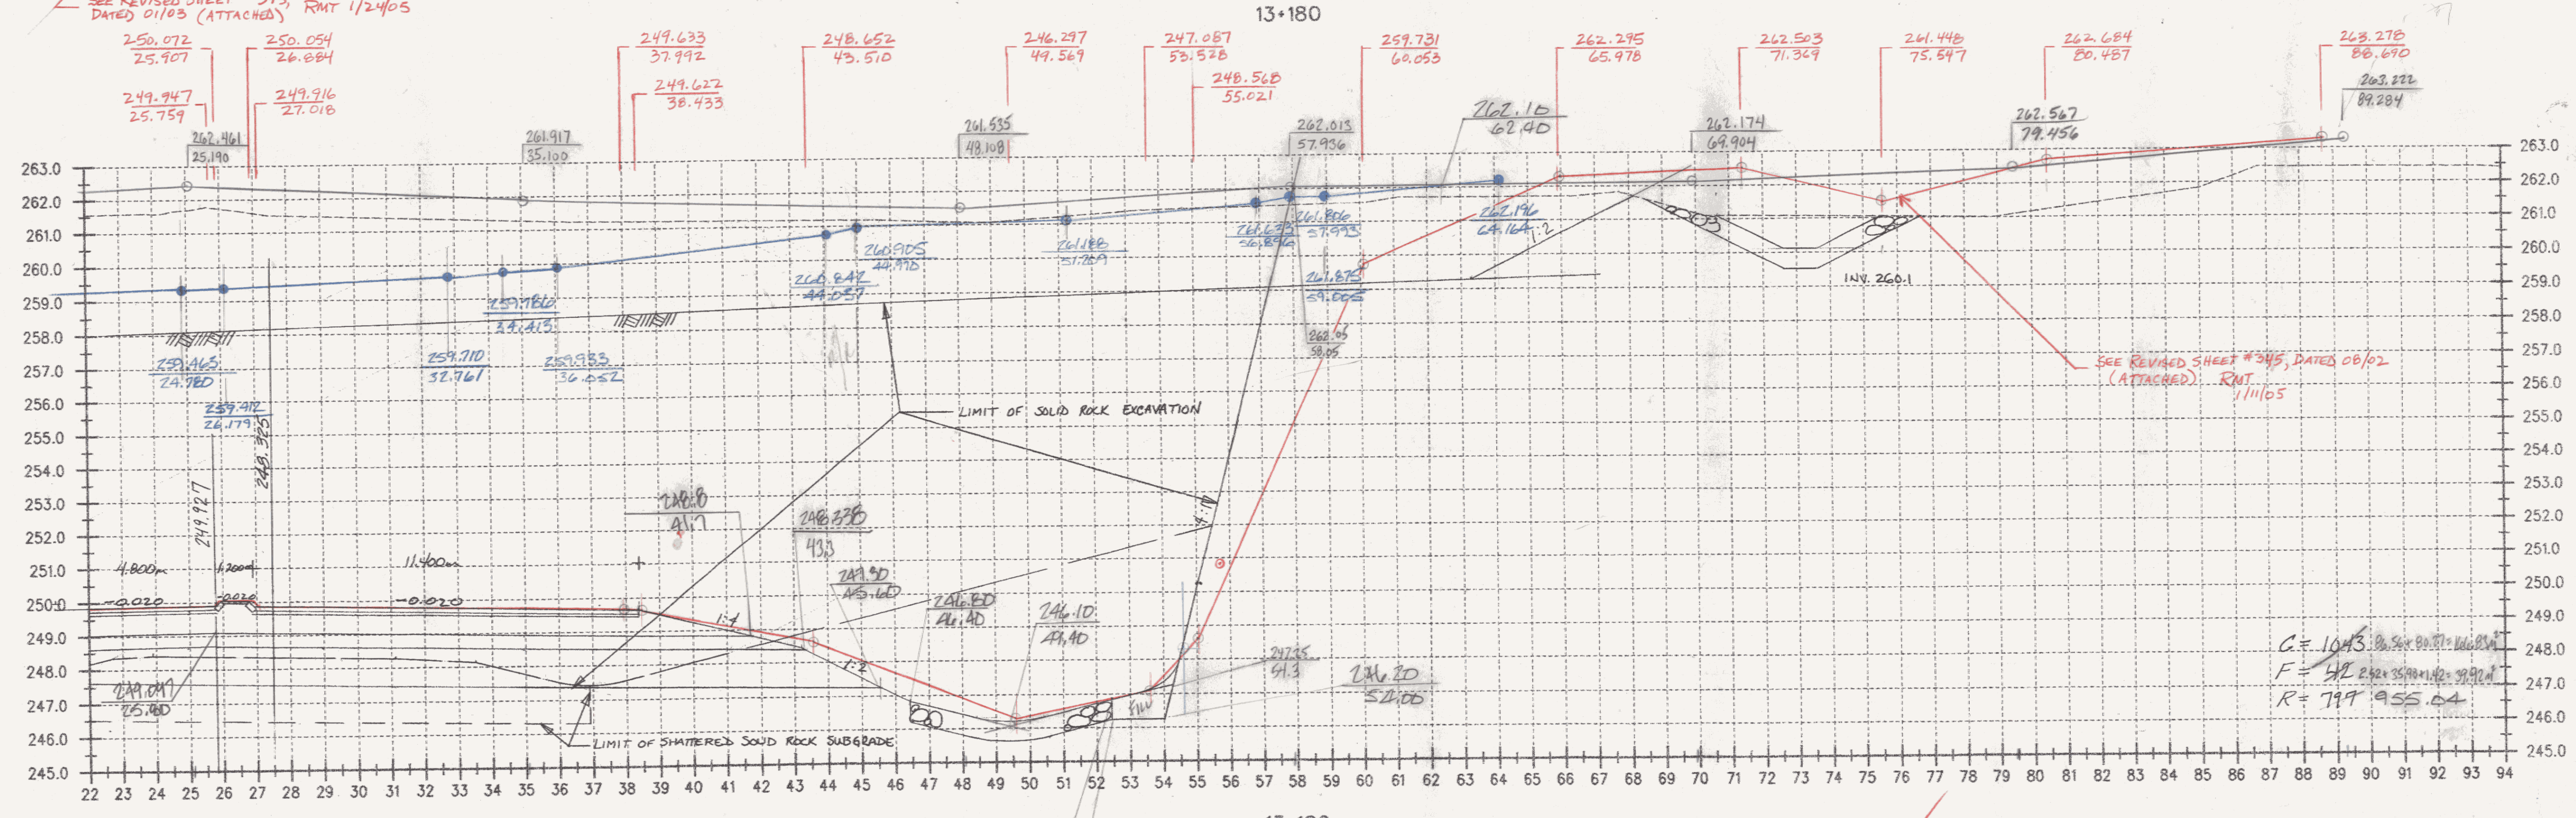

SEE REVISED SHEET #345, DATED 08/02 (ATTACHED) RMT 1/11/05

G = 1043  
 F = 512  
 R = 797

DATUM	
VERTICAL	NAVD 1988
HORIZONTAL	N/A

FG. RMT 1/11/05

O.G. Drawn By  
 DA 1/15/03  
 Checked By

ALL DIMENSIONS IN MILLIMETERS EXCEPT AS INDICATED  
 2 0 2 m  
 H 1:100  
 V 1:100

SURVEYED BY	C.H.A. & V.S.E.	DATE	
DRAWN BY	J.S.L.	DATE	
SQUAD LEADER	T.P.K.		
DESIGN FILE NO.	N/A		
IPARM FILE		DATE PLOTTED	
PROJ. NAME	BENNINGTON - HOOSICK		
	D.P.I. 0146(1) C/3		
PROJ. NO.	P.I.N. 1306.60.201		
SHEET	345 OF 473 SHEETS		