


13+180

Run  
FG. 1/24/05

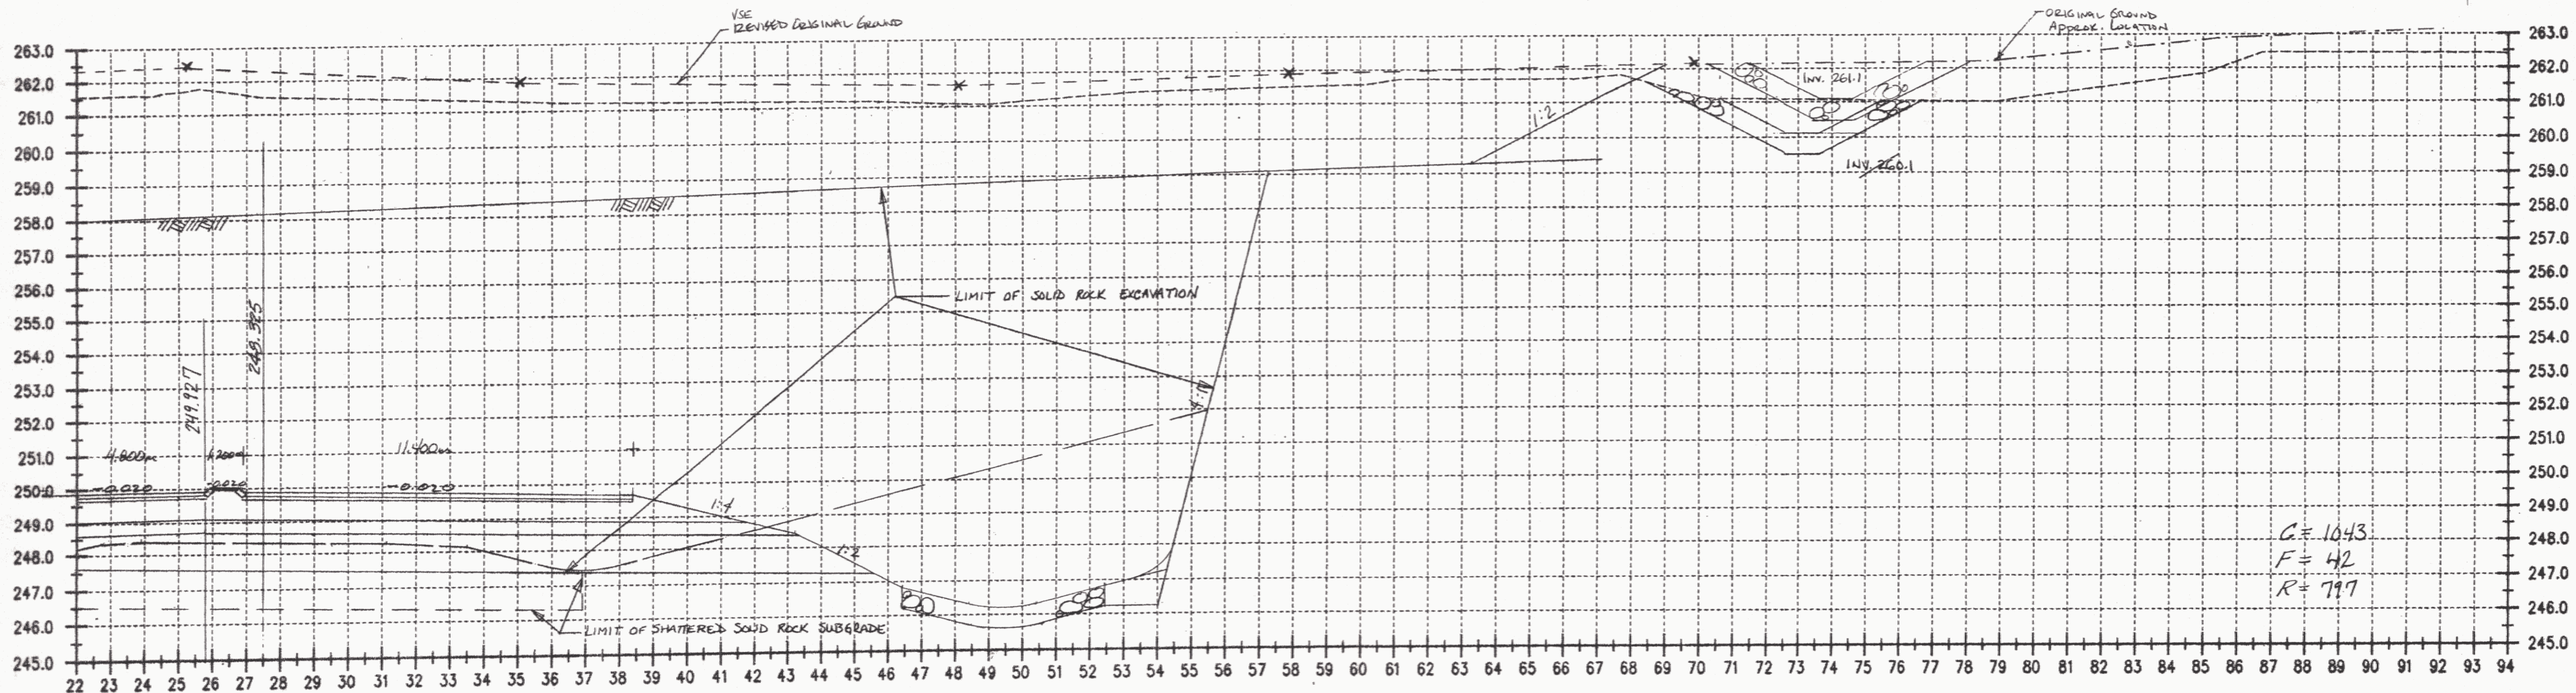

13+180

G = 1043  
F = 42  
R = 797

DATUM  
VERTICAL NAVD 1988  
HORIZONTAL N/A

ALL DIMENSIONS IN MILLIMETERS EXCEPT AS INDICATED  
2 0 2 m  
H 1:100  
V 1:100

SURVEYED BY C.H.A. & V.S.E. DATE  
DRAWN BY J.S.L. DATE  
SQUAD LEADER T.P.K. REV. 01/03  
DESIGN FILE NO. N/A  
DATE PLOTTED  
PARM FILE  
PROJ. NAME BENNINGTON - HOOSICK D.P.I. 0146(1) C/3  
PROJ. NO. P.I.N. 1306.60.201  
SHEET 345 OF 473 SHEETS