


SEE REVISED SHEET #346,
DATED 01/03 (ATTACHED)
RMT 11/24/05

15.73 P.P.S.
13+200
B-356

19.4
2.1
14.7

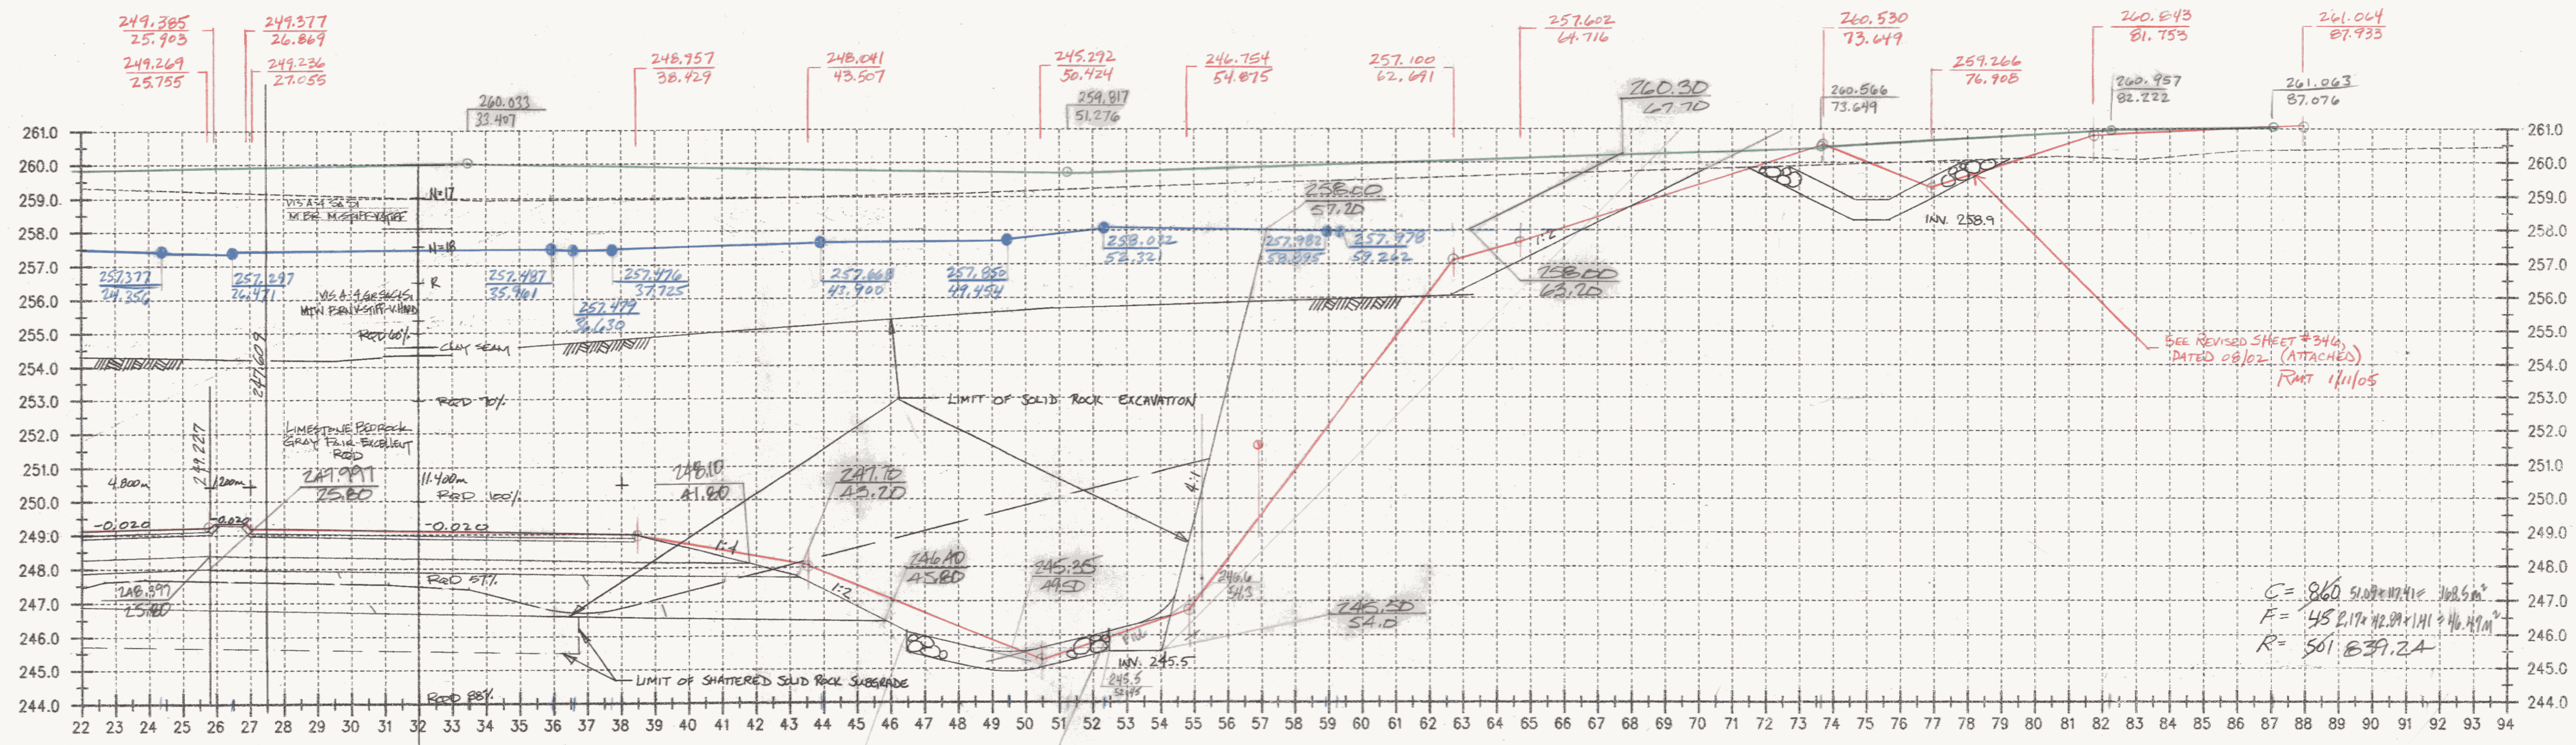

SEE REVISED SHEET #346,
DATED 08/02 (ATTACHED)
RMT 11/10/05

18.04 P.P.S.
B-362


13+200

DATUM	
VERTICAL	NAVD 1988
HORIZONTAL	N/A

FG RMT 11/10/05

Orig. Drawn By
DH 11/15/05

Checked By:
ALL DIMENSIONS IN MILLIMETERS
EXCEPT AS INDICATED

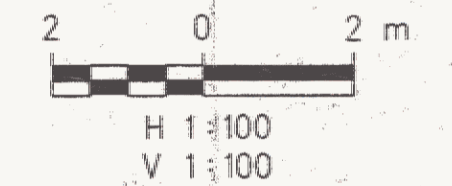

SURVEYED BY	C.H.A. & V.S.E.	DATE	
DRAWN BY	J.S.L.	DATE	
SQUAD LEADER	T.P.K.		
DESIGN FILE NO.	N/A		
IPARM FILE		DATE PLOTTED	
PROJ. NAME	BENNINGTON - HOOSICK		
	D.P.I. 0146(1) c/3		
PROJ. NO.	P.I.N. 1306.60.201		
SHEET	346 OF 473 SHEETS		