


DATUM	
VERTICAL	NAVD 1988
HORIZONTAL	N/A

FG RUT 11/3/05 ✓

ALL DIMENSIONS IN MILLIMETERS EXCEPT AS INDICATED

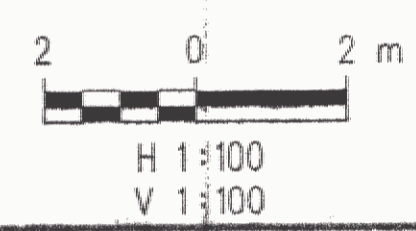

SURVEYED BY	C.H.A. & V.S.E.	DATE	
DRAWN BY	J.S.L.	DATE	
SQUAD LEADER	T.P.K.	Rev.	05/02
DESIGN FILE NO.	N/A		
IPARM FILE	DATE PLOTTED		
PROJ. NAME	BENNINGTON - HOOSICK D.P.I. 0146(1) C/3		
PROJ. NO.	P.I.N. 1306.60.201		
SHEET	346 OF 473 SHEETS		

RFD