


B-356  
15.73 P.P.S.  
13+200


RMT  
FG 1/24/05

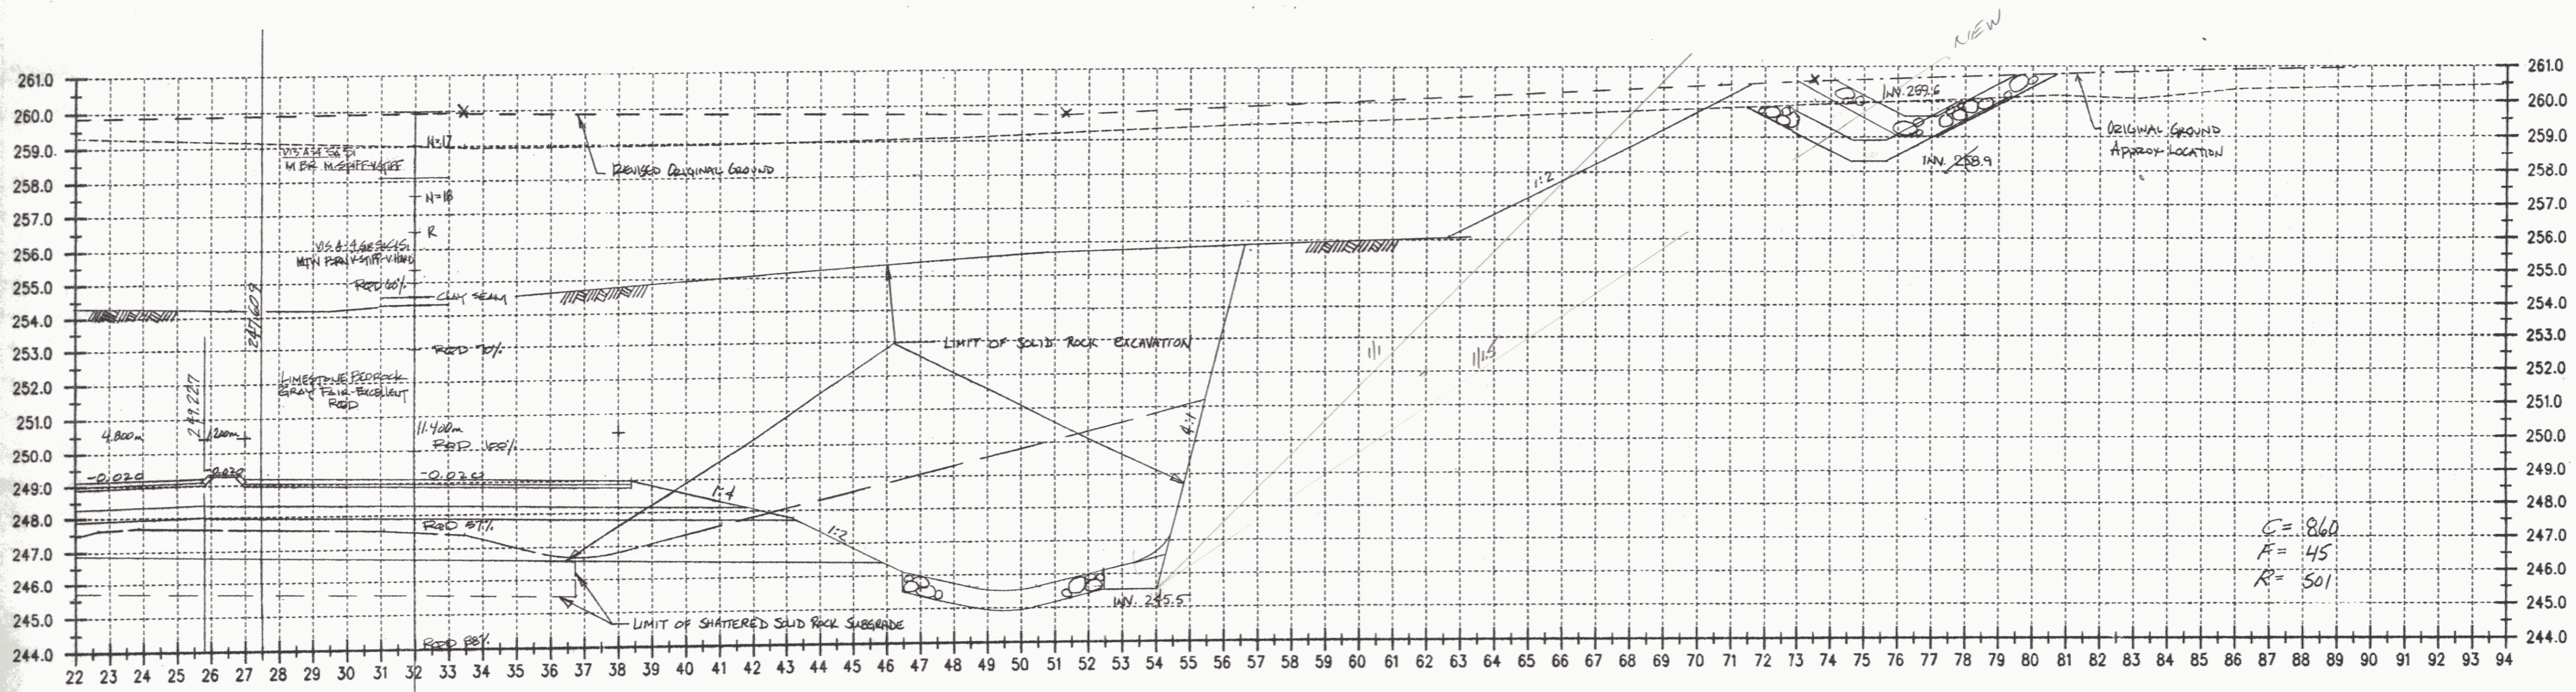

B-362  
19.04 P.P.S.  
13+200

C = 860  
F = 45  
R = 501

DATUM	
VERTICAL	NAVD 1988
HORIZONTAL	N/A

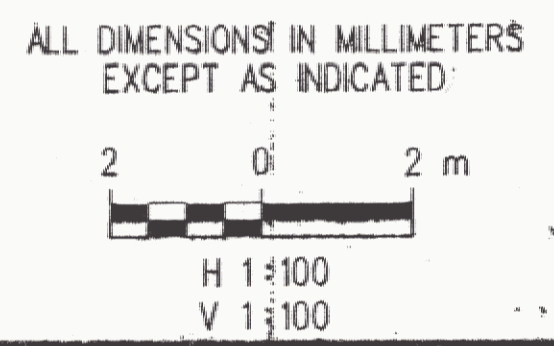

SURVEYED BY	C.H.A. & V.S.E.	DATE	
DRAWN BY	J.S.L.	DATE	
SQUAD LEADER	T.P.K.	REV.	08/02
DESIGN FILE NO.	N/A		
IPARM FILE	DATE PLOTTED		
PROJ. NAME	BENNINGTON - HOOSICK D.P.I. 0146(1) C13		
PROJ. NO.	P.I.N. 1306.60.201 RMT 1/24/05		
SHEET 346 OF 473 SHEETS			