


SEE REVISED SHEET #347,
DATED 01/03 (ATTACHED)
RMT 11/24/05

13+220

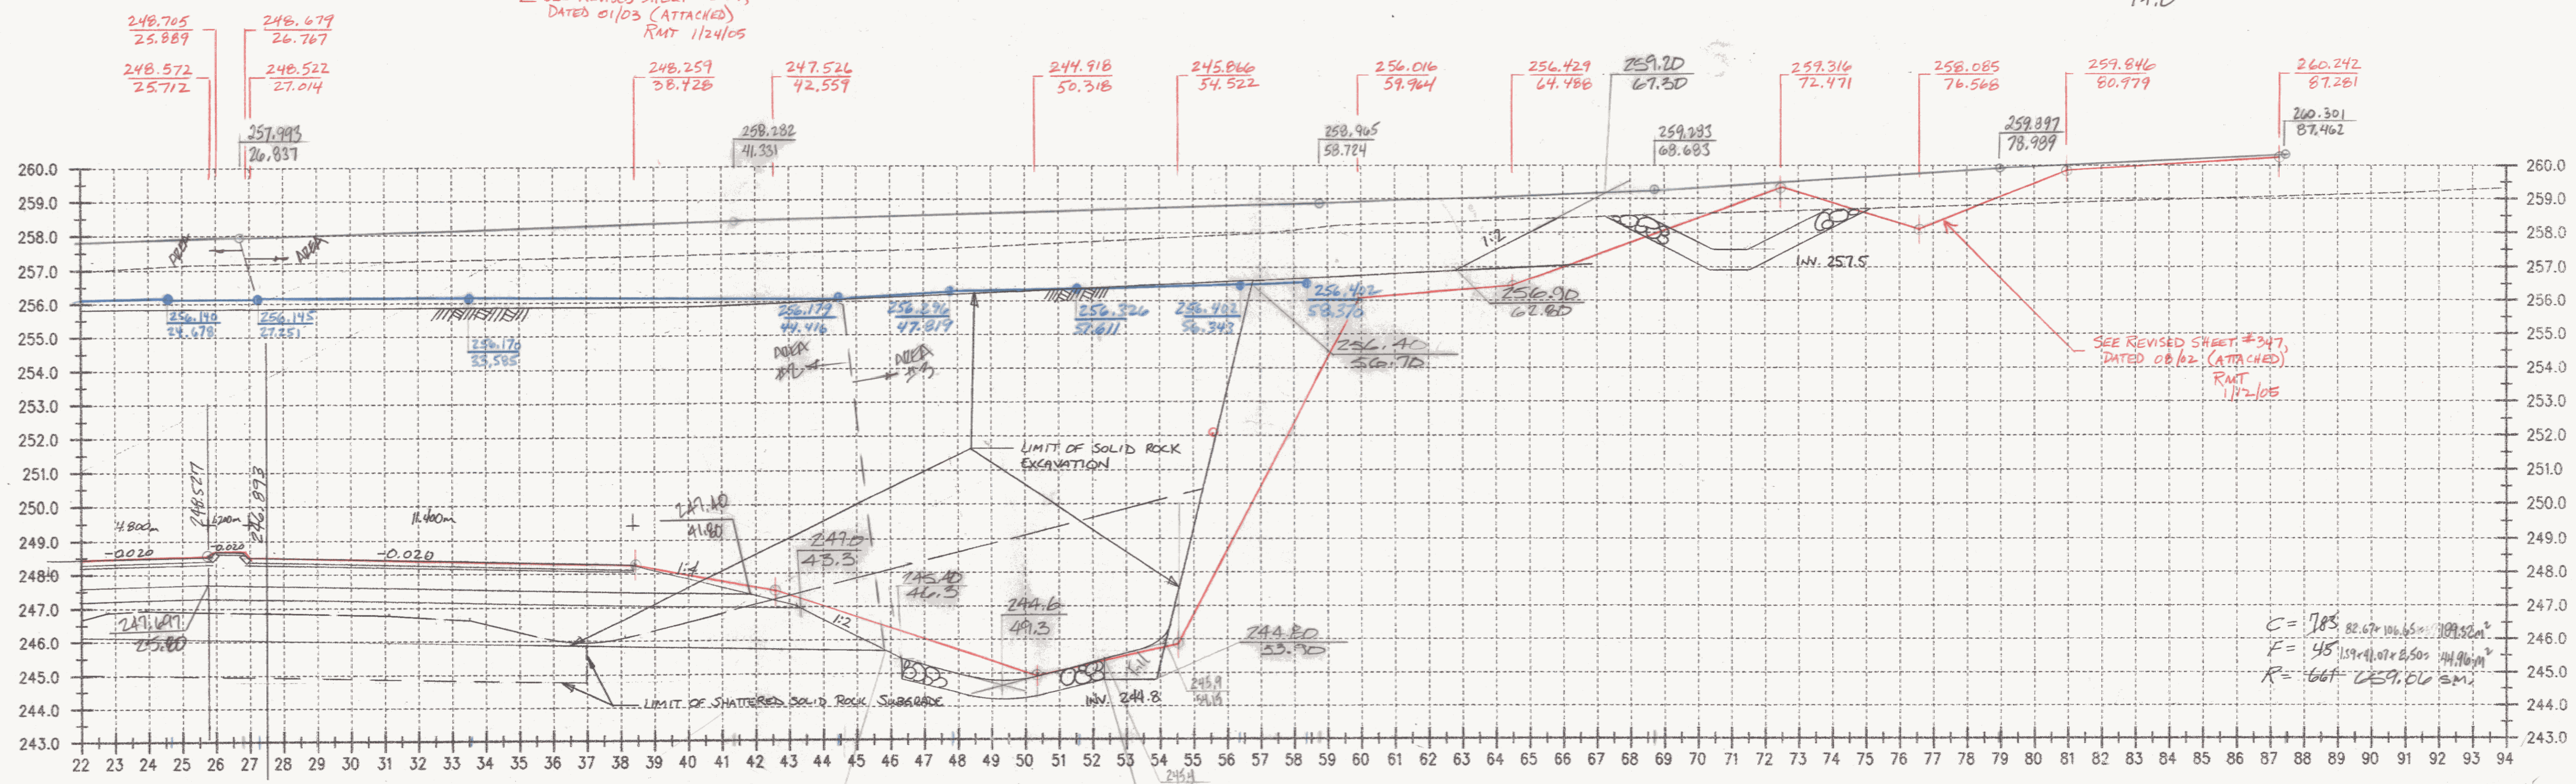

SEE REVISED SHEET #347,
DATED 01/02 (ATTACHED)
RMT 11/2/05

13+220

DATUM	
VERTICAL	NAVD 1988
HORIZONTAL	N/A

O.G. DRAWING BY:
DH 1/15/03 KRM 1/15/03

FG: RMT 11/2/05 *[Signature]*

ALL DIMENSIONS IN MILLIMETERS EXCEPT AS INDICATED

2 0 2 m

H 1:100
V 1:100

SURVEYED BY	C.H.A. & V.S.E.	DATE	
DRAWN BY	J.S.L.	DATE	
SQUAD LEADER	T.P.K.		
DESIGN FILE NO.	N/A		
IPARM FILE		DATE PLOTTED	
PROJ. NAME	BENNINGTON - HOOSICK D.P.I. 0146(1) C/3		
PROJ. NO.	P.I.N. 1306.60.201		
SHEET	347 OF 473 SHEETS		

17.4
14.9