


13+220


RMT
FG 1/24/05

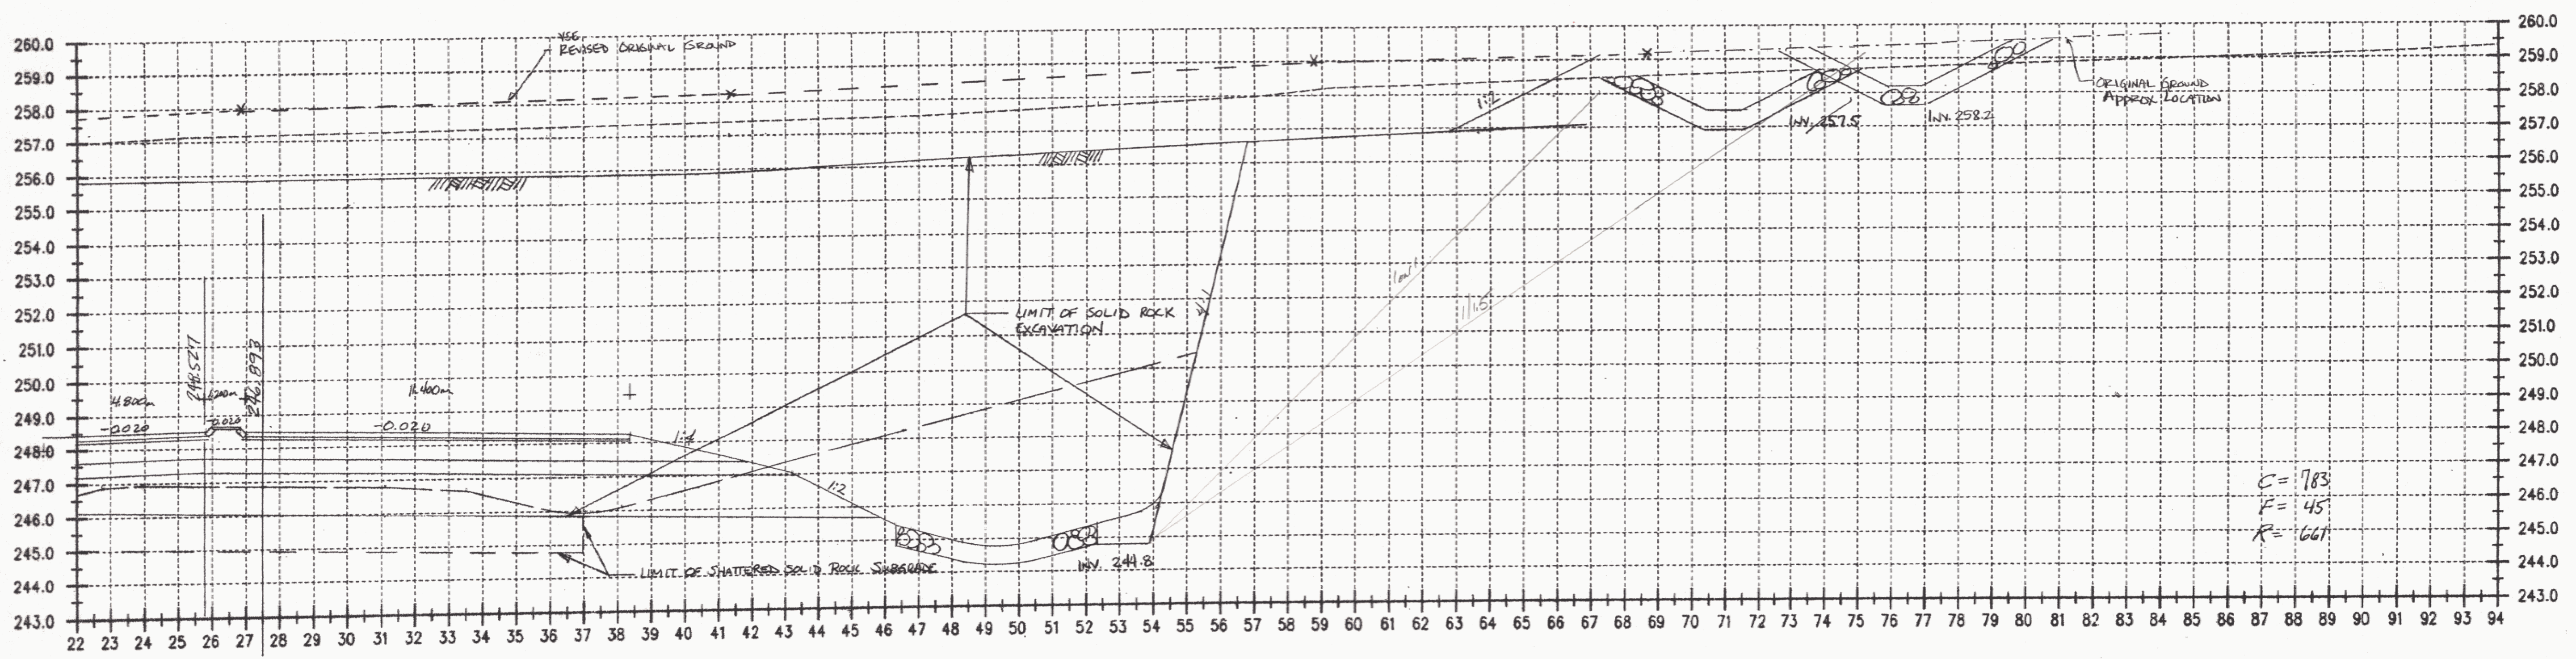

13+220

C = 1783
E = 45
R = 661

DATUM	
VERTICAL	NAVD 1988
HORIZONTAL	N/A

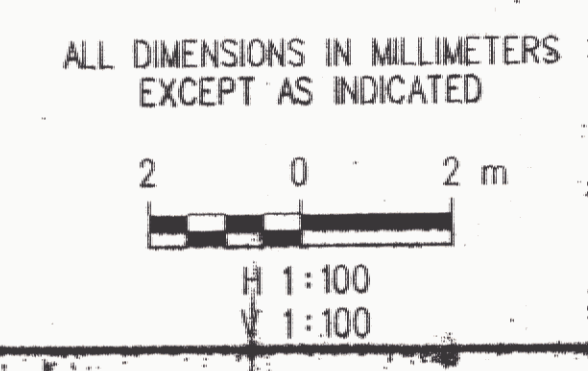

SURVEYED BY	C.H.A. & V.S.E.	DATE	
DRAWN BY	J.S.L.	DATE	
SQUAD LEADER	T.P.K.	REV	01/05
DESIGN FILE NO.	N/A		
IPARM FILE	DATE PLOTTED		
PROJ. NAME	BENNINGTON - HOOSICK		
PROJ. NO.	D.P.I. 0146(1) C/3		
	REV. 01/05		
	RMT 1/24/05		
SHEET	347 OF 473 SHEETS		