


SEE REVISED SHEET # 34B,  
DATED 01/03 (ATTACHED)  
RMT 11/24/05

13+240

P.B  
1.8  
4.8

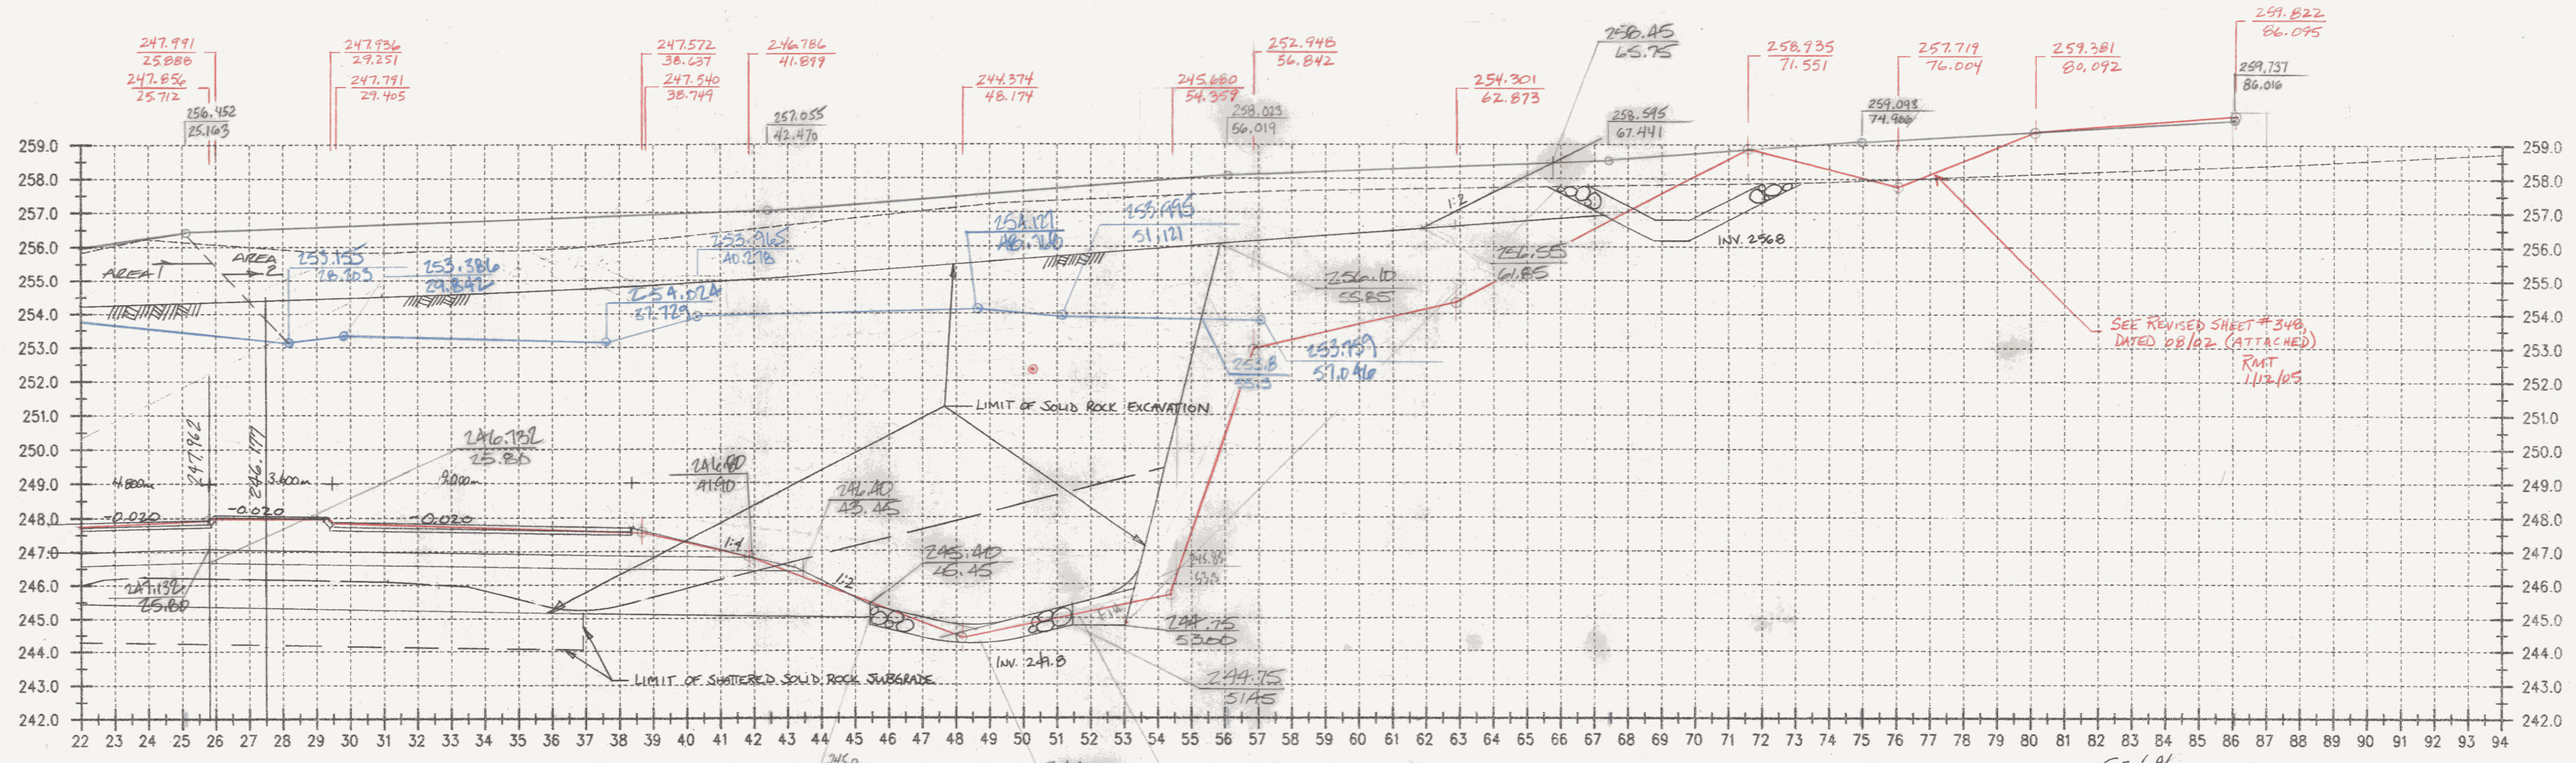

SEE REVISED SHEET # 34B,  
DATED 08/02 (ATTACHED)  
RMT 11/24/05

13+240

DATUM	
VERTICAL	NAVD 1988
HORIZONTAL	N/A

O.G. Detail By: \_\_\_\_\_  
 ON 11/12/05  
 FG. RMT 11/24/05

$C = 696$   
 $F = 4H \cdot 229 + 4433 + 0.60 = 49,22m^2$   
 $R = 567 \cdot 649,11$

ALL DIMENSIONS IN MILLIMETERS  
 EXCEPT AS INDICATED

2 0 2 m  
 H 1:100  
 V 1:100

SURVEYED BY	C.H.A. & V.S.E.	DATE	
DRAWN BY	J.S.L.	DATE	
SQUAD LEADER	T.P.K.		
DESIGN FILE NO.	N/A		
IPARM FILE		DATE PLOTTED	
PROJ. NAME	BENNINGTON - HOOSICK		
PROJ. NO.	D.P.I. 0146(1) C/3		
SHEET	348 OF 473 SHEETS		