


13+240

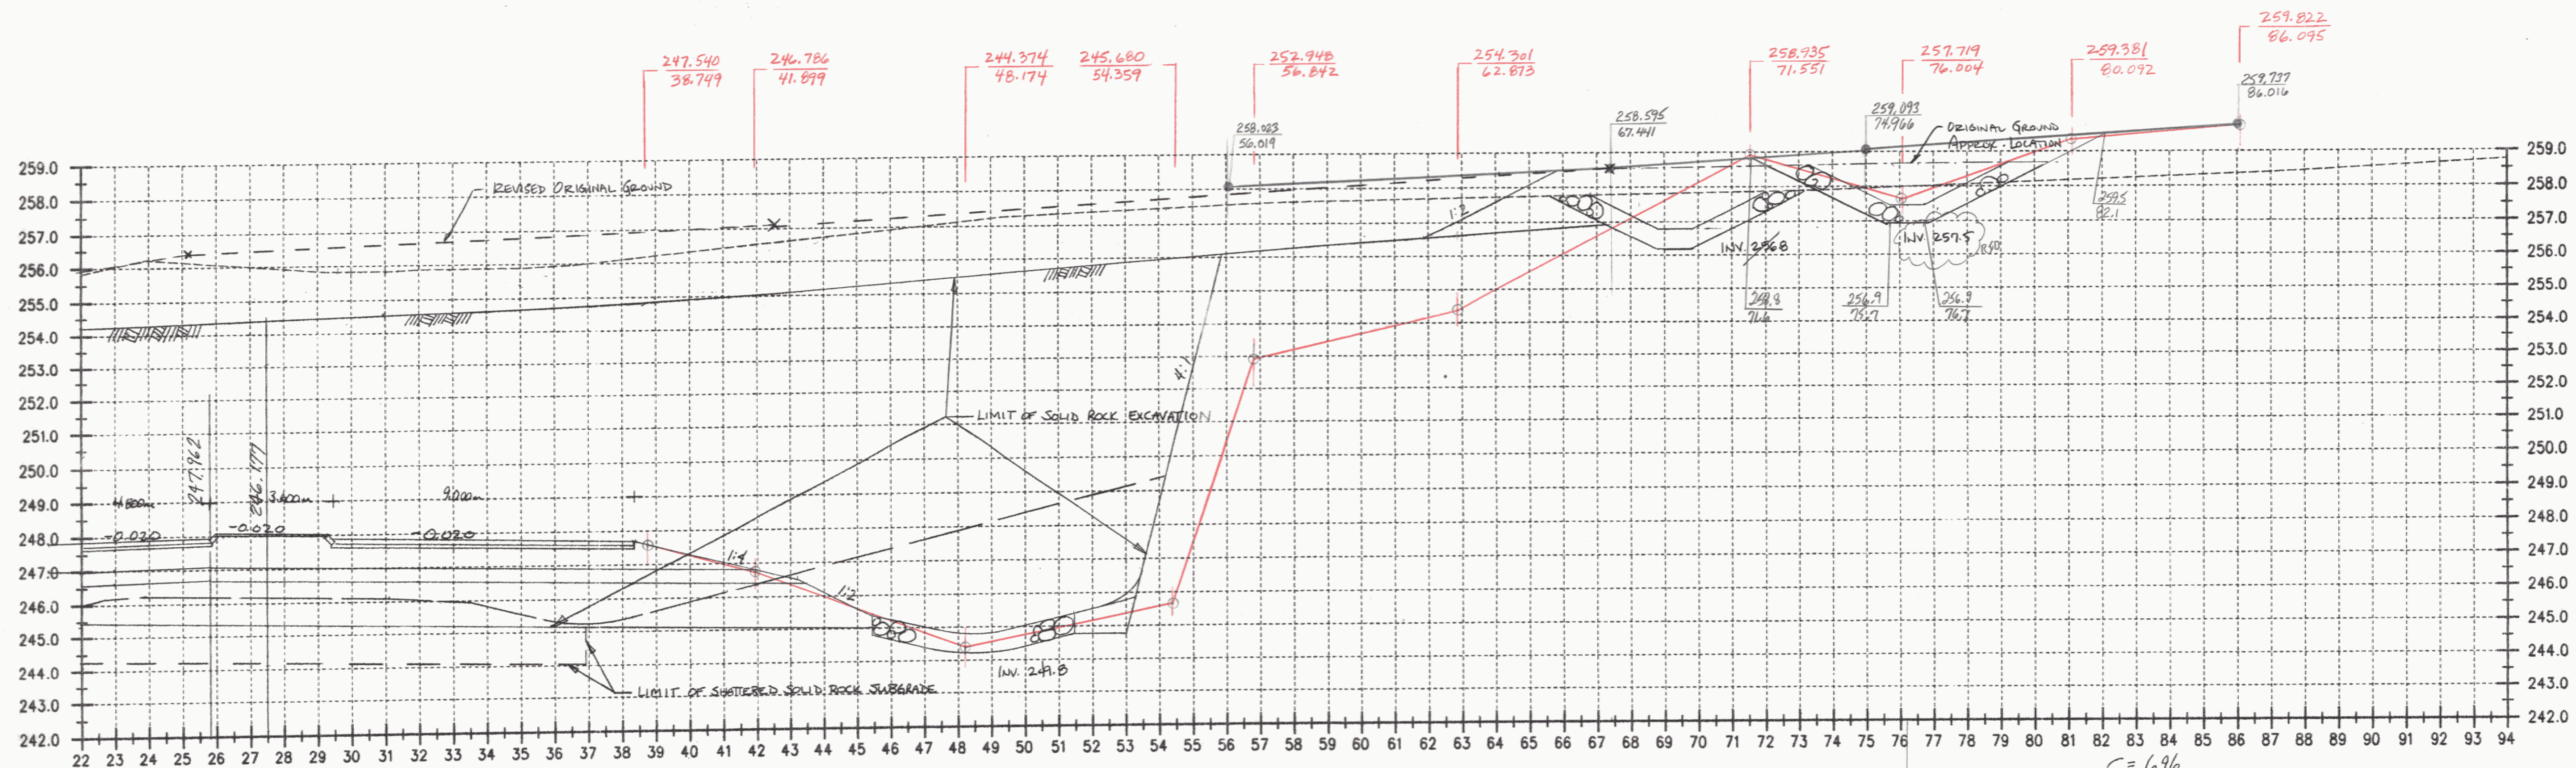


13+240

C = 6.96  
F = 42  
R = 56.7

FG. RNT 1/13/85 ✓ BL

ALL DIMENSIONS IN MILLIMETERS EXCEPT AS INDICATED

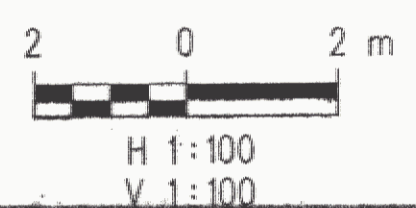

SURVEYED BY	C.H.A. & V.S.E.	DATE	
DRAWN BY	J.S.L.	DATE	
SQUAD LEADER	T.P.K.	REV.	08/02
DESIGN FILE NO.	N/A		
IPARM FILE		DATE PLOTTED	
PROJ. NAME	BENNINGTON - HOOSICK		
	D.P.I. 0146(1) C/3		
PROJ. NO.	P.I.N. 1306.60.201		
SHEET	348 OF 473 SHEETS		

DATUM	
VERTICAL	NAVD 1988
HORIZONTAL	N/A

RFD